


1 LOCATION OF WATER WELL: <b>Sedgwick</b>	FRACTION <b>NW 1/4 NE 1/4 NW 1/4</b>	Section Number <b>29</b>	Township Number <b>T 25 S</b>	Range Number <b>R 1E EW</b>
--	---	-----------------------------	----------------------------------	--------------------------------

Distance and direction from nearest town or city street address of well if located within city?  
**701 W. 93rd N. Valley Center, Kansas**

2 WATER WELL OWNER: <b>BARTON, Roger</b>	Board of Agriculture, Division of Water Resource
RR#, ST. ADDRESS, BOX #: <b>701 W. 93rd N.</b>	Application Number:
CITY, STATE, ZIP CODE: <b>Valley Center, Kansas</b>	

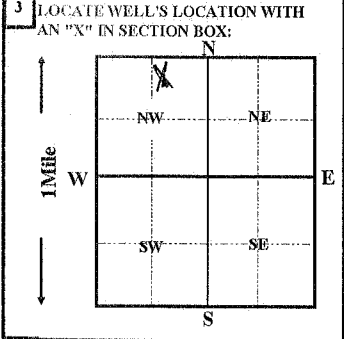

4 DEPTH OF COMPLETED WELL <b>90</b> ft.	ELEVATION:	mo/day/yr
Depth(s) groundwater Encountered <b>1</b> ft.	<b>2</b> ft.	<b>3</b> ft.
WELL'S STATIC WATER LEVEL <b>30</b> FT. BELOW LAND SURFACE MEASURED ON	<b>10/16/1995</b>	
Pump test data:	Well water was	ft. after
Est. Yield	gpm:	Well water was
Bore Hole Diameter	<b>12</b> in. to <b>90</b>	ft. after
WELL WATER TO BE USED AS:	<b>5</b> Public water supply	<b>8</b> Air conditioning
<b>1</b> Domestic	<b>3</b> Feedlot	<b>6</b> Oil field water supply
<b>2</b> Irrigation	<b>4</b> Industrial	<b>7</b> Lawn and garden only
		<b>9</b> Dewatering
		<b>10</b> Monitoring well
		<b>11</b> Injection well
		<b>12</b> Other (Specify below)
Was a chemical/bacteriological sample submitted to Department? Yes	No <input checked="" type="checkbox"/>	; If yes, mo/day/yr sample was
submitted	Water Well Disinfected? Yes <input checked="" type="checkbox"/> No	

5 TYPE OF CASING USED:	5 Wrought iron	8 Concrete tile	CASING JOINTS:
<b>1</b> Steel	<b>3</b> RMP (SR)	<b>6</b> Asbestos-Cement	Glued <input checked="" type="checkbox"/> Clamped
<b>2</b> PVC	<b>4</b> ABS	<b>7</b> Fiberglass	Welded
Blank casing Diameter <b>5</b> in. to <b>40</b> ft., Dia	in. to	ft., Dia	in. to
Casing height above land surface <b>12</b> in.,	weight <b>2.35</b> lbs. / ft.	Wall thickness or gauge No. <b>.214</b>	
TYPE OF SCREEN OR PERFORATION MATERIAL:	<b>7</b> PVC	<b>10</b> Asbestos-cement	
<b>1</b> Steel	<b>3</b> Stainless Steel	<b>5</b> Fiberglass	<b>8</b> RMP (SR)
<b>2</b> Brass	<b>4</b> Galvanized steel	<b>6</b> Concrete tile	<b>9</b> ABS
SCREEN OR PERFORATION OPENING ARE:	<b>5</b> Gauzed wrapped	<b>8</b> Saw cut	<b>11</b> None (open hole)
<b>1</b> Continuous slot	<b>3</b> Mill slot	<b>9</b> Drilled holes	
<b>2</b> Louvered shutter	<b>4</b> Key punched	<b>7</b> Torch cut	<b>10</b> Other (specify)
SCREEN-PERFORATION INTERVALS:	from <b>40</b> ft. to <b>90</b> ft., From	ft. to	ft.
GRAVEL PACK INTERVALS:	from <b>24</b> ft. to <b>90</b> ft., From	ft. to	ft.

6 GROUT MATERIAL:	1 Neat cement	2 Cement grout	3 Bentonite	4 Other
Grout Intervals: From <b>4</b> ft. to <b>24</b> ft. From	ft. to	ft. From	ft. to	ft. From
What is the nearest source of possible contamination:	<b>1</b> Septic tank	<b>4</b> Lateral lines	<b>7</b> Pit privy	<b>10</b> Livestock pens
<b>2</b> Sewer lines	<b>5</b> Cess pool	<b>8</b> Sewage lagoon	<b>11</b> Fuel storage	<b>14</b> Abandon water well
<b>3</b> Watertight sewer lines	<b>6</b> Seepage pit	<b>9</b> Feedyard	<b>12</b> Fertilizer storage	<b>15</b> Oil well/Gas well
			<b>13</b> Insecticide storage	<b>16</b> Other (specify below)
Direction from well?	<b>None Apparent</b>			

FROM	TO	LITHOLOGIC LOG	FROM	TO	How many feet?
0	4	topsoil			
4	18	clay			
18	32	fine sand			
32	90	gray shale			

7 CONTRACTOR'S OR LANDOWNER'S CERTIFICATION: This water well was (1) constructed, (2) reconstructed, or (3) plugged under my jurisdiction and was completed on (mo/day/year) <b>10/16/1995</b> and this record is true to the best of my knowledge and belief. Kansas Water Well Contractor's License No. <b>236</b> This Water Well Record was completed on (mo/day/yr) <b>10/17/95</b> Under the business name of <b>Harp Well &amp; Pump Service, Inc</b> by (signature)	<p><i>Jane Frederick</i></p>
---	------------------------------