


<b>1</b> LOCATION OF WATER WELL: <b>Sedgwick</b>	FRACTION <b>SW 1/4 SE 1/4 NW 1/4</b>	Section Number <b>31</b>	Township Number <b>T 25 S</b>	Range Number <b>R 1E E/W</b>
---	---	-----------------------------	----------------------------------	---------------------------------

Distance and direction from nearest town or city street address of well if located within city?  
**200' N. of Main St. in alley between Colby & Dexter Valley Center, KS.**

WATER WELL OWNER: <b>VALLEY CENTER, CITY OF</b>	Board of Agriculture, Division of Water Resource
RR#, ST. ADDRESS, BOX #: <b>116 S. Park</b>	Application Number:
CITY, STATE, ZIP CODE: <b>Valley Center, Kansas</b>	

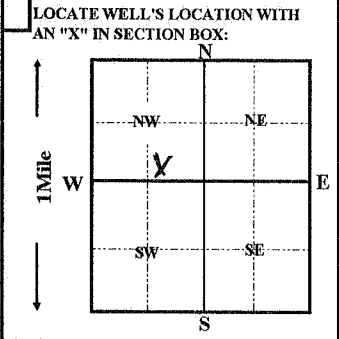

**4** DEPTH OF COMPLETED WELL **40** ft. ELEVATION:

Depth(s) groundwater Encountered 1 ft. 2 ft. 3 ft.

WELL'S STATIC WATER LEVEL **15** FT. BELOW LAND SURFACE MEASURED ON **05/04/1998**

Pump test data: Well water was ft. after hours pumping gpm

Est. Yield gpm: Well water was ft. after hours pumping gpm

Bore Hole Diameter **12** in. to **40** ft. and in. to ft.

WELL WATER TO BE USED AS:

5 Public water supply	8 Air conditioning	11 Injection well
1 Domestic	3 Feedlot	6 Oil field water supply
2 Irrigation	4 Industrial	7 Lawn and garden only
		9 Dewatering
		10 Monitoring well
		12 Other (Specify below)

Was a chemical/bacteriological sample submitted to Department? Yes No **X**; If yes, mo/day/yr sample was submitted Water Well Disinfected? Yes **X** No

**5** TYPE OF CASING USED:

1 Steel	3 RMP (SR)	5 Wrought iron	8 Concrete tile	CASING JOINTS:	Glued <b>X</b> Clamped
2 PVC	4 ABS	6 Asbestos-Cement	9 Other (Specify below)		Welded
		7 Fiberglass	<b>SDR-26</b>		Threaded

Blank casing Diameter **8** in. to **20** ft., Dia in. to ft., Dia in. to ft.

Casing height above land surface **12** in., weight **5.52** lbs. / ft. Wall thickness or gauge No. **.332**

TYPE OF SCREEN OR PERFORATION MATERIAL:

1 Steel	3 Stainless Steel	5 Fiberglass	8 RMP (SR)	10 Asbestos-cement
2 Brass	4 Galvanized steel	6 Concrete tile	9 ABS	11 other (specify)
				12 None used (open hole)

SCREEN OR PERFORATION OPENING ARE:

1 Continuous slot	3 Mill slot	5 Gauzed wrapped	8 Saw cut	11 None (open hole)
2 Louvered shutter	4 Key punched	6 Wire wrapped	9 Drilled holes	
		7 Torch cut	10 Other (specify)	

SCREEN-PERFORATION INTERVALS: from **20** ft. to **40** ft., From ft. to ft.

GRAVEL PACK INTERVALS: from **20** ft. to **40** ft., From ft. to ft.

**6** GROUT MATERIAL: 1 Neat cement 2 Cement grout 3 Bentonite 4 Other **bentonite hole plug**

Grout Intervals: From **2** ft. to **20** ft. From ft. to ft. From ft. to ft.

What is the nearest source of possible contamination:

1 Septic tank	4 Lateral lines	7 Pit privy	10 Livestock pens	14 Abandon water well
2 Sewer lines	5 Cess pool	8 Sewage lagoon	11 Fuel storage	15 Oil well/Gas well
3 Watertight sewer lines	6 Seepage pit	9 Feedyard	12 Fertilizer storage	16 Other (specify below)
			13 Insecticide storage	<b>None Apparent</b>

Direction from well?		LITHOLOGIC LOG		How many feet?	
FROM	TO	FROM	TO	PLUGGING INTERVALS	
0	4				
		topsoil			
4	10				
		clay			
10	23				
		medium fine sand			
23	40				
		medium sand			

**7** CONTRACTOR'S OR LANDOWNER'S CERTIFICATION: This water well was (1) constructed, (2) reconstructed, or (3) plugged under my jurisdiction and was completed on (mo/day/year) **05/04/1998** and this record is true to the best of my knowledge and belief. Kansas Water Well Contractor's License No. **236** This Water Well Record was completed on (mo/day/yr) **05/05/98**

Under the business name of **Harp Well & Pump Service, Inc** by (signature) *Todd S. Harp*