


1 LOCATION OF WATER WELL: Sedgwick	FRACTION SE 1/4 SE 1/4 SW 1/4	Section Number 31	Township Number T 25 S	Range Number R 1E E/W
--	---	-----------------------------	----------------------------------	---------------------------------

Distance and direction from nearest town or city street address of well if located within city?

715 Valley Park Valley Center, Kansas

WATER WELL OWNER: DRASSEN, Joe	Board of Agriculture, Division of Water Resource
RR#, ST. ADDRESS, BOX #: 715 Valley Park	
CITY, STATE, ZIP CODE: Valley Center, Kansas	Application Number:

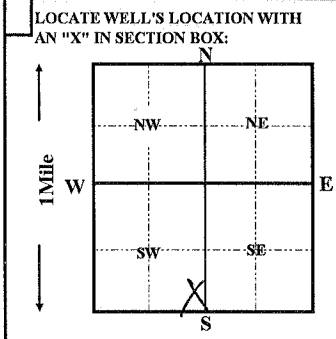

4 DEPTH OF COMPLETED WELL	35	ft.	ELEVATION:	
Depth(s) groundwater Encountered	1	ft.	2	ft.
WELL'S STATIC WATER LEVEL	15	FT. BELOW LAND SURFACE MEASURED ON	08/19/1998	mo/day/yr
Pump test data:				
Well water was	ft.	after	hours pumping	gpm
Est. Yield gpm:	Well water was	ft.	after	hours pumping
Bore Hole Diameter	12	in.	to	35
		ft.	and	in.
WELL WATER TO BE USED AS:	5	Public water supply	8	Air conditioning
	11	Injection well	12	Other (Specify below)
1 Domestic	3	Feedlot	6	Oil field water supply
2 Irrigation	4	Industrial	7	Lawn and garden only
			8	Monitoring well
Was a chemical/bacteriological sample submitted to Department? Yes <input type="checkbox"/> No <input checked="" type="checkbox"/> ; If yes, mo/day/yr sample was submitted _____				
Water Well Disinfected? Yes <input checked="" type="checkbox"/> No <input type="checkbox"/>				

5 TYPE OF CASING USED:	5 Wrought iron	8 Concrete tile	CASING JOINTS:	Glued <input checked="" type="checkbox"/> Clamped
1 Steel	3 RMP (SR)	6 Asbestos-Cement		Welded
2 PVC	4 ABS	7 Fiberglass	SDR-26	Threaded
Blank casing Diameter	5	in.	to	24
		ft.	Dia	ft.
Casing height above land surface	12	in.	weight	2.35
		lbs./ft.	Wall thickness or gauge No.	.214
TYPE OF SCREEN OR PERFORATION MATERIAL:				
1 Steel	3 Stainless Steel	5 Fiberglass	8 RMP (SR)	11 other (specify)
2 Brass	4 Galvanized steel	6 Concrete tile	9 ABS	12 None used (open hole)
SCREEN OR PERFORATION OPENING ARE:				
1 Continuous slot		3 Mill slot		5 Gauzed wrapped
2 Louvered shutter		4 Key punched		6 Wire wrapped
				7 Torch cut
SCREEN-PERFORATION INTERVALS:		from	24	ft. to
		ft.	to	35
		ft., From	ft. to	ft.
GRAVEL PACK INTERVALS:				
		from	24	ft. to
		ft.	to	35
		ft., From	ft. to	ft.

6 GROUT MATERIAL:	1 Neat cement	2 Cement grout	3 Bentonite	4 Other bentonite hole plug
Grout Intervals: From	4	ft. to	24	ft.
What is the nearest source of possible contamination:				
1 Septic tank	4 Lateral lines	7 Pit privy	10 Livestock pens	14 Abandon water well
2 Sewer lines	5 Cess pool	8 Sewage lagoon	11 Fuel storage	15 Oil well/Gas well
3 Watertight sewer lines	6 Seepage pit	9 Feedyard	12 Fertilizer storage	16 Other (specify below)
Direction from well? West			How many feet? 30	

FROM	TO	LITHOLOGIC LOG	FROM	TO	PLUGGING INTERVALS
0	2	topsoil			
2	8	clay			
8	15	fine sand			
15	35	medium sand			

7 CONTRACTOR'S OR LANDOWNER'S CERTIFICATION: This water well was (1) constructed, (2) reconstructed, or (3) plugged under my jurisdiction and was completed on (mo/day/year) **08/19/1998** and this record is true to the best of my knowledge and belief. Kansas Water Well Contractor's License No. **236** This Water Well Record was completed on (mo/day/yr) **08/21/98**

Under the business name of **Harp Well & Pump Service, Inc** by (signature) *Todd S. Harp*