

# County Permit

## WATER WELL RECORD Form WWC-5


Original Record    Correction    Change in Well Use

Division of Water Resources App. No.  

Well ID  

**1 LOCATION OF WATER WELL:** County: Sedgwick Fraction: 1/4 NE 1/4 NW 1/4 NE 1/4 Section Number: 8 Township Number: T 25 S Range Number: R 1 E

**2 WELL OWNER:** Last Name: Dennett First: Jason Street or Rural Address where well is located (if unknown, distance and direction from nearest town or intersection): If at owner's address, check here:   
 Business: 319 W 117th St N  
 Address: Sedgwick City: Sedgwick State: Ks ZIP:  

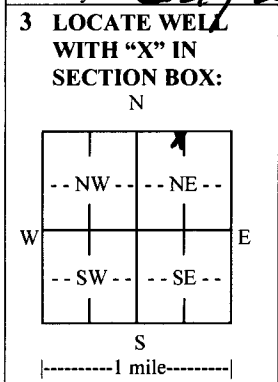

**4 DEPTH OF COMPLETED WELL:** 80 ft.  
 Depth(s) Groundwater Encountered: 1)   ft. 2)   ft. 3)   ft. or 4)  Dry Well  
 WELL'S STATIC WATER LEVEL: 33 ft.  
 below land surface, measured on (mo-day-yr).....  
 above land surface, measured on (mo-day-yr).....  
 Pump test data: Well water was   ft. after..... hours pumping ..... gpm  
 Well water was   ft. after..... hours pumping ..... gpm  
 Estimated Yield:   gpm  
 Bore Hole Diameter: 1.7 in. to   ft. and   in. to   ft.

**5 Latitude:** ..... (decimal degrees)  
**Longitude:** ..... (decimal degrees)  
 Datum:  WGS 84    NAD 83    NAD 27  
**Source for Latitude/Longitude:**  
 GPS (unit make/model: ..... (WAAS enabled?  Yes  No)  
 Land Survey    Topographic Map  
 Online Mapper: .....

**7 WELL WATER TO BE USED AS:**

1. Domestic: <input type="checkbox"/> Household <input checked="" type="checkbox"/> Lawn & Garden <input type="checkbox"/> Livestock 2. <input type="checkbox"/> Irrigation 3. <input type="checkbox"/> Feedlot 4. <input type="checkbox"/> Industrial	5. <input type="checkbox"/> Public Water Supply: well ID ..... 6. <input type="checkbox"/> Dewatering: how many wells? ..... 7. <input type="checkbox"/> Aquifer Recharge: well ID ..... 8. <input type="checkbox"/> Monitoring: well ID ..... 9. Environmental Remediation: well ID ..... <input type="checkbox"/> Air Sparge <input type="checkbox"/> Soil Vapor Extraction <input type="checkbox"/> Recovery <input type="checkbox"/> Injection	10. <input type="checkbox"/> Oil Field Water Supply: lease ..... 11. Test Hole: well ID ..... <input type="checkbox"/> Cased <input type="checkbox"/> Uncased <input type="checkbox"/> Geotechnical 12. Geothermal: how many bores? ..... a) Closed Loop <input type="checkbox"/> Horizontal <input type="checkbox"/> Vertical b) Open Loop <input type="checkbox"/> Surface Discharge <input type="checkbox"/> Inj. of Water 13. <input type="checkbox"/> Other (specify): .....
--	--	---

**Was a chemical/bacteriological sample submitted to KDHE?**  Yes    No   If yes, date sample was submitted: .....

Water well disinfected?  Yes    No

**8 TYPE OF CASING USED:**  Steel    PVC    Other ..... CASING JOINTS:  Glued    Clamped    Welded    Threaded  
 Casing diameter 5 in. to 80 ft., Diameter ..... in. to ..... ft., Diameter ..... in. to ..... ft.  
 Casing height above land surface 16 in. Weight 160 lbs./ft. Wall thickness or gauge No. 20

**TYPE OF SCREEN OR PERFORATION MATERIAL:**  
 Steel    Stainless Steel    Fiberglass    PVC    Other (Specify) .....  
 Brass    Galvanized Steel    Concrete tile    None used (open hole)

**SCREEN OR PERFORATION OPENINGS ARE:**  
 Continuous Slot    Mill Slot    Gauze Wrapped    Torch Cut    Drilled Holes    Other (Specify) .....  
 Louvered Shutter    Key Punched    Wire Wrapped    Saw Cut    None (Open Hole)

**SCREEN-PERFORATED INTERVALS:** From 40 ft. to 80 ft., From ..... ft. to ..... ft., From ..... ft. to ..... ft.  
**GRAVEL PACK INTERVALS:** From 24 ft. to 80 ft., From ..... ft. to ..... ft., From ..... ft. to ..... ft.

**9 GROUT MATERIAL:**  Neat cement    Cement grout    Bentonite    Other .....  
 Grout Intervals: From 4 ft. to 24 ft., From ..... ft. to ..... ft., From ..... ft. to ..... ft.

**Nearest source of possible contamination:**  
 Septic Tank    Lateral Lines    Pit Privy    Livestock Pens    Insecticide Storage  
 Sewer Lines    Cess Pool    Sewage Lagoon    Fuel Storage    Abandoned Water Well  
 Watertight Sewer Lines    Seepage Pit    Feedyard    Fertilizer Storage    Oil Well/Gas Well  
 Other (Specify) North .....  
 Direction from well? North Distance from well? 33 ft.

10 FROM	TO	LITHOLOGIC LOG	FROM	TO	LITHO. LOG (cont.) or PLUGGING INTERVALS
0	2	Top Soil			
2	17	Clay			
17	27	fine sand - clay			
27	36	med sand			
36	41	Green Shale			
41	80	Blue shale			
<b>Notes:</b>					

**11 CONTRACTOR'S OR LANDOWNER'S CERTIFICATION:** This water well was  constructed,  reconstructed, or  plugged under my jurisdiction and was completed on (mo-day-yr) 10/26/13 and this record is true to the best of my knowledge and belief. Kansas Water Well Contractor's License No. 1011 This Water Well Record was completed on (mo-day-yr) 11/24/13 under the business name of Chase Drilling