


1	LOCATION OF WATER WELL: County: Sedgwick	Fraction NW ¼ NW ¼ SW ¼	Section Number 31	Township Number T 25 S	Range Number R 1
---	--	----------------------------	----------------------	---------------------------	---------------------

Distance and direction from nearest town or city street address of well if located within city?
100 S. Meridian, Valley Center

2 WATER WELL OWNER: **Kansas Dept. of Health & Environment**

RR#, St. Address, Box # : **1000 SW Jackson St., Suite 410**
City, State, ZIP Code : **Topeka, Kansas 66612-1367**
Board of Agriculture, Division of Water Resources
Application Number:

3 LOCATE WELL'S LOCATION WITH AN "X" IN SECTION BOX:

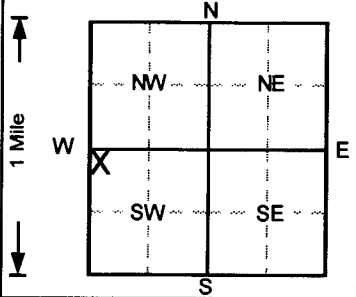

4 DEPTH OF COMPLETED WELL: **19.75** ft. ELEVATION: **1344.24**

Depth(s) Groundwater Encountered 1. ft 2. ft 3. ft

WELL'S STATIC WATER LEVEL: ft below land surface measured on mo/day/yr

Pump test data: Well water was **NA** ft. after hours pumping gpm

Est. Yield .. **NA** .. gpm: Well water was ft. after hours pumping gpm

Bore Hole Diameter .. **11** .. in. to .. **19.75** .. ft., and in. to ft.

WELL WATER TO BE USED AS: 5 Public water supply 8 Air conditioning 11 Injection well
1 Domestic 3 Feedlot 6 Oil field water supply 9 Dewatering (12) Other (Specify below)
2 Irrigation 4 Industrial 7 Lawn and garden only 10 Monitoring well **Soil vapor extract. . . .**

Was a chemical/bacteriological sample submitted to Department? Yes.....No✓
Water Well Disinfected? Yes No ✓

5 TYPE OF BLANK CASING USED:

- 1 Steel 2 PVC (2)
- 3 RMP (SR) 4 ABS
- 5 Wrought iron 6 Asbestos-Cement 7 Fiberglass
- 8 Concrete tile 9 Other (specify below)

Blank casing diameter 4 in. to 9.75 ft., Dia. in. to ft., Dia. in. to ft.

Casing height above land surface -5.76 in., weight lbs./ft. Wall thickness or gauge No. **Sch. 40**

TYPE OF SCREEN OR PERFORATION MATERIAL

- 1 Steel 2 Brass 3 Stainless steel 4 Galvanized steel 5 Fiberglass 6 Concrete tile 7 PVC (7)
- 8 RMP (SR) 9 ABS 10 Asbestos-cement 11 Other (specify) 12 None used (open hole)

SCREEN OR PERFORATION OPENINGS ARE:

- 1 Continuous slot 2 Louvered shutter 3 Mill slot (3) 4 Key punched 5 Gauzed wrapped 6 Wire wrapped 7 Torch cut 8 Saw cut 9 Drilled holes 11 None (open hole) 10 Other (specify)

SCREEN-PERFORATED INTERVALS: From 9.75 ft to 19.75 ft, From ft to ft

GRAVEL PACK INTERVALS: From 8.75 ft to 19.75 ft, From ft to ft

6 GROUT MATERIAL: 1 Neat cement 2 Cement grout 3 Bentonite (3) 4 Other

Grout intervals: From 3.75 ft to 8.75 ft, From ft to ft

What is the nearest source of possible contamination:

- 1 Septic tank 2 Sewer lines 3 Watertight sewer lines 4 Lateral lines 5 Cess pool 6 Seepage pit 7 Pit privy 8 Sewage lagoon 9 Feedyard 10 Livestock pens 11 Fuel storage 12 Fertilizer storage 13 Insecticide storage 14 Abandoned water well 15 Oil well/Gas well 16 Other (specify below)

Direction from well? How many feet?

FROM	TO	LITHOLOGIC LOG	FROM	TO	PLUGGING INTERVALS
0.75	4.75	Clay, silty, Brown			
4.75	12.75	Gravel fill, 1/4 to 3/4" w/fines, Lt. Gray			
12.75	19.75	Sand, vf-c, Gray Brown to Brown			
					SVE1 , Flushmount

7 CONTRACTOR'S OR LANDOWNER'S CERTIFICATION: This water well was (1) constructed, (2) reconstructed, or (3) plugged under my jurisdiction and was completed on (mo/day/year) **9/5/2014** and this record is true to the best of my knowledge and belief.

Kansas Water Well Contractor's License No. **527** This Water Well Record was completed on (mo/day/yr) **9/12/14** under the business name of **GeoCore, Inc.** by (signature) **Dale Hill**