

WATER WELL PLUGGING RECORD Form WWC-5P

KSA 82a-1212

ID NO.

| | | | | |
|---|--------------------------------------|--------------------------|-------------------------------|--|
| 1 LOCATION OF WATER WELL: County: <u>Sedgwick</u> | Fraction <u>SW 1/4 SE 1/4 SW 1/4</u> | Section Number <u>31</u> | Township Number <u>T 25 S</u> | Range Number <u>W 1</u> <input checked="" type="checkbox"/> E <input type="checkbox"/> |
|---|--------------------------------------|--------------------------|-------------------------------|--|

Street Rural Address of Well Location: if unknown, distance & direction from nearest town or intersection: If at owner's address, check here


Global Positioning Systems (GPS) information:

Latitude: 37.826578 (in decimal degrees)
 Longitude: -97.366285 (in decimal degrees)
 Elevation: _____
 Datum: WGS84, NAD83, NAD27
 Collection Method: _____

2 WATER WELL OWNER: Mark + Leanda Weaver
 RR#, St. Address, Box #: 515 E Valley Park Dr
 City, State ZIP Code: Valley Center, KS 67147

GPS unit (Make/Model): _____
 Digital Map/Photo, Topographic Map, Land Survey
 Est. Accuracy: < 3 m, 3-5 m, 5-15 m, > 15 m

3 MARK WELL'S LOCATION WITH AN "X" IN SECTION BOX:

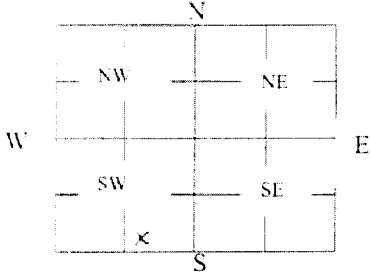

4 DEPTH OF WELL 18 ft.

WELL'S STATIC WATER LEVEL Dry ft.

WELL WAS USED AS:

- | | | |
|-------------------------------------|---|--|
| <input type="checkbox"/> Domestic | <input type="checkbox"/> Public Water Supply | <input type="checkbox"/> Dewatering |
| <input type="checkbox"/> Irrigation | <input type="checkbox"/> Oil Field Water Supply | <input checked="" type="checkbox"/> Monitoring |
| <input type="checkbox"/> Feedlot | <input type="checkbox"/> Domestic (Lawn & Garden) | <input type="checkbox"/> Injection Well |
| <input type="checkbox"/> Industrial | <input type="checkbox"/> Air Conditioning | <input type="checkbox"/> Other _____ |

Was a chemical/bacteriological sample submitted to Department? Yes No

5 TYPE OF BLANK CASING USED:

- Steel RMP (SR) Wrought Fiberglass Other (Specify below)
 PVC ABS Asbestos-Cement Concrete Tile

Blank casing diameter 1 in. Was casing pulled? Yes No If yes, how much 0-9' Pulled
 Casing height above or below land surface _____ m.

Casing broke @ 8' BGS.

6 GROUT PLUG MATERIAL:

- Neat cement Cement grout Bentonite Other _____

Grout Plug Intervals: From 1 ft. to 18 ft., From _____ ft. to _____ ft., From _____ to _____ ft.

What is the nearest source of possible contamination:

- | | | | |
|---|---|---|---|
| <input type="checkbox"/> Septic tank | <input type="checkbox"/> Seepage pit | <input type="checkbox"/> Fuel Storage | <input checked="" type="checkbox"/> Other (specify below) |
| <input type="checkbox"/> Sewer lines | <input type="checkbox"/> Pit privy | <input type="checkbox"/> Fertilizer storage | <u>Natural CO2</u> |
| <input type="checkbox"/> Watertight sewer lines | <input type="checkbox"/> Sewage lagoon | <input type="checkbox"/> Insecticide storage | |
| <input type="checkbox"/> Lateral lines | <input type="checkbox"/> Feedyard | <input type="checkbox"/> Abandoned water well | Direction from well? _____ |
| <input type="checkbox"/> Cess pool | <input type="checkbox"/> Livestock pens | <input type="checkbox"/> Oil well/Gas well | How many feet? _____ |

| FROM | TO | PLUGGING MATERIALS | FROM | TO | PLUGGING MATERIALS |
|----------|-----------|--------------------|------|----|--------------------|
| <u>1</u> | <u>18</u> | <u>Bentonite</u> | | | |
| <u>0</u> | <u>1</u> | <u>Sand</u> | | | |
| | | | | | |
| | | | | | |
| | | | | | |

7 CONTRACTOR'S OR LANDOWNER'S CERTIFICATION: This water well was plugged under my jurisdiction and was completed on (mo/day/year) 10/26/15 and this record is true to the best of my knowledge and belief. Kansas Water Well Contractor's License No. 628. This Water Well Record was completed on (mo/day/year) 10/28/15 under the business name of JM Enterprises by (signature) James Meyer

INSTRUCTIONS: Use typewriter or ballpoint pen. Please press firmly and print clearly. Please fill in blanks, underline or circle the correct answers. Send top three copies to Kansas Department of Health and Environment, Bureau of Water, Geology Section, 1000 SW Jackson St., Ste. 420, Topeka, Kansas 66612-1367. Telephone: 785/296-5524. Send one to Water Well Owner and retain one for your records. Visit us at <http://www.kdheks.gov/waterwell/index.html>.