

WATER WELL PLUGGING RECORD Form WWC-5P KSA 82a-1212 ID NO.

1 **LOCATION OF WATER WELL:** Fraction 1/4 SW 1/4 SW 1/4 SW 1/4 Section Number 2 Township Number T 25 S Range Number 1 ☒ E ☐ W
County: Sedgwick

Street/Rural Address of Well Location; if unknown, distance & direction from nearest town or intersection: If at owner's address, check here ☐ Located approximately 1 mile south and 0.50 miles east of Sedgwick, KS


Global Positioning Systems (GPS) information:

Latitude: 37.897760 (in decimal degrees)
Longitude: -97.408360 (in decimal degrees)
Elevation: _____
Horizontal Datum: ☐ WGS84, ☐ NAD83, ☒ NAD27
Collection Method: _____

2 **WATER WELL OWNER:** Barbara Anne Works Liv Trust
RR#, St. Address, Box #: 12158 N Hoover Rd
City, State ZIP Code: Sedgwick, KS 67135

☒ GPS unit (Make/Model: Garmin GPSmap 60CSx)
☐ Digital Map/Photo, ☐ Topographic Map, ☐ Land Survey
Est. Accuracy: ☐ < 3 m, ☒ 3-5 m, ☐ 5-15 m, ☐ > 15 m

3 **MARK WELL'S LOCATION WITH AN "X" IN SECTION BOX:**

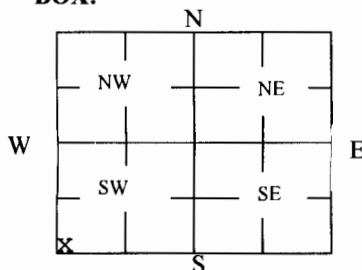

4 **DEPTH OF WELL** 61.2 **ft.**

WELL'S STATIC WATER LEVEL 15.61 **ft**

WELL WAS USED AS:

☐ Domestic ☐ Public Water Supply ☐ Dewatering
☐ Irrigation ☐ Oil Field Water Supply ☐ Monitoring
☐ Feedlot ☐ Domestic (Lawn & Garden) ☐ Injection Well
☐ Industrial ☐ Air Conditioning ☒ Other Unknown

Was a chemical/bacteriological sample submitted to Department? Yes ☐ No ☒

5 **TYPE OF BLANK CASING USED:**

☐ Steel ☐ RMP (SR) ☐ Wrought ☐ Fiberglass ☐ Other (Specify below)
☒ PVC ☐ ABS ☐ Asbestos-Cement ☐ Concrete Tile

Blank casing diameter 5 in. Was casing pulled? Yes ☐ No ☒ If yes, how much _____
Casing height above or below land surface below 36 in.

6 **GROUT PLUG MATERIAL:** ☐ Neat cement ☐ Cement grout ☒ Bentonite ☐ Other _____

Grout Plug Intervals: From 15.61 ft. to 3 ft., From _____ ft. to _____ ft., From _____ ft. to _____ ft.

What is the nearest source of possible contamination:

☐ Septic tank ☐ Seepage pit ☒ Fuel storage ☐ Other (specify below)
☐ Sewer lines ☐ Pit privy ☐ Fertilizer storage
☐ Watertight sewer lines ☐ Sewage lagoon ☐ Insecticide storage
☐ Lateral lines ☐ Feedyard ☐ Abandoned water well Direction from well? northwest
☐ Cess pool ☐ Livestock pens ☐ Oil well/Gas well How many feet? approximately 1075 feet

FROM	TO	PLUGGING MATERIALS	FROM	TO	PLUGGING MATERIALS
61.2	15.61	Clean, coarse sand			Well plugging witnessed by
15.61	3	Bentonite Hole Plug			D. Randolph, GMD2 staff,
3	0	Topsoil			on 12/12/2016.

7 **CONTRACTOR'S OR LANDOWNER'S CERTIFICATION:** This water well was plugged under my jurisdiction and was completed on (mo/day/year) 12/12/2016 and this record is true to the best of my knowledge and belief. Kansas Water Well Contractor's License No. _____. This Water Well Record was completed on (mo/day/year) 12/20/2016 under the business name of _____ by (signature) Paul U. Workman

Send one copy to Kansas Department of Health & Environment, Geology Section, 1000 SW Jackson Street, Ste. 420, Topeka, KS 66612-1367. Send one copy to WATER WELL OWNER and retain one for your records.

JAN 05 2017

Visit us at <http://www.kdheks.gov/waterwell/index.html>

Telephone 785-296-5524.

KSA82a-1212

Revised 1/20/2015