


1 LOCATION OF WATER WELL: Fraction NE 1/4 SE 1/4 NE 1/4 Section Number 4 Township Number T 25 S Range Number R 1 E  
 County: SEDGWICK

Distance and direction from nearest town or city street address of well if located within city?

1625 E. RYAN RD - SEDGWICK

2 WATER WELL OWNER: KENNETH KEEFER  
 RR#, St. Address, Box #: 1625 E. RYAN RD.  
 City, State, ZIP Code: SEDGWICK, KS 67135  
 Board of Agriculture, Division of Water Resources  
 Application Number:

3 LOCATE WELL'S LOCATION WITH AN "X" IN SECTION BOX:

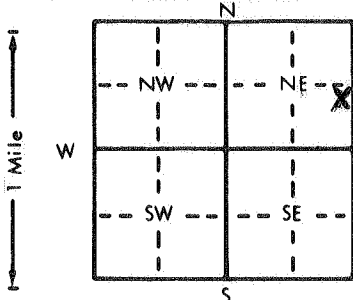

4 DEPTH OF COMPLETED WELL: 416 ft. ELEVATION:

Depth(s) Groundwater Encountered 1. 20 ft. 2. 20 ft. 3. 11-12-87 ft.

WELL'S STATIC WATER LEVEL 20 ft. below land surface measured on mo/day/yr

Pump test data: Well water was 20 ft. after 1/2 hours pumping 20 gpm

Est. Yield 35 gpm: Well water was 20 ft. after 1/2 hours pumping 20 gpm

Bore Hole Diameter 11 in. to 416 ft. and 416 in. to 416 ft.

WELL WATER TO BE USED AS:

1 Domestic 3 Feedlot 6 Oil field water supply 9 Dewatering 12 Other (Specify below)

2 Irrigation 4 Industrial 7 Lawn and garden only 10 Observation well

Was a chemical/bacteriological sample submitted to Department? Yes X No X; If yes, mo/day/yr sample was submitted

Water Well Disinfected? Yes X No X

5 TYPE OF BLANK CASING USED:

1 Steel 3 RMP (SR) 5 Wrought iron 8 Concrete tile CASING JOINTS: Glued X Clamped X

2 PVC 4 ABS 6 Asbestos-Cement 9 Other (specify below) Welded X


Casing height above land surface 12 in. weight 1.59 lbs./ft. Wall thickness or gauge No. SPR-216

TYPE OF SCREEN OR PERFORATION MATERIAL:

1 Steel 3 Stainless steel 5 Fiberglass 7 PVC 10 Asbestos-cement

2 Brass 4 Galvanized steel 6 Concrete tile 8 RMP (SR) 11 Other (specify)

SCREEN OR PERFORATION OPENINGS ARE:

1 Continuous slot 3 Mill slot 5 Gauzed wrapped 8 Saw cut 11 None (open hole)

2 Louvered shutter 4 Key punched 6 Wire wrapped 9 Drilled holes







What is the nearest source of possible contamination:

1 Septic tank 4 Lateral lines 7 Pit privy 10 Livestock pens 14 Abandoned water well

2 Sewer lines 5 Cess pool 8 Sewage lagoon 11 Fuel storage 15 Oil well/Gas well

3 Watertight sewer lines 6 Seepage pit 9 Feedyard 12 Fertilizer storage 16 Other (specify below)

Direction from well? SW How many feet? 105

FROM TO LITHOLOGIC LOG FROM TO LITHOLOGIC LOG

0 2 Top soil

2 14 Clay

14 20 fine sand

20 23 clay

23 35 med sand

35 46 Clay & shale -

CONTRACTOR'S OR LANDOWNER'S CERTIFICATION: This water well was (1) constructed (2) reconstructed, or (3) plugged under my jurisdiction and was completed on (mo/day/year) Nov 12, 1987 and this record is true to the best of my knowledge and belief, Kansas

Water Well Contractor's License No. 318 This Water Well Record was completed on (mo/day/yr) Nov 12, 1987

under the business name of Wendy Drilling by (signature) James W. Wingo

INSTRUCTIONS: Use typewriter or ball point pen. PLEASE PRESS FIRMLY and PRINT clearly. Please fill in blanks, underline or circle the correct answers. Send top three copies to Kansas

Department of Health and Environment, Bureau of Water Protection, Topeka, Kansas 66620-7320, Telephone: 913-862-9360. Send one to WATER WELL OWNER and retain one for your records.