


1 LOCATION OF WATER WELL: Fraction NW 1/4 SE 1/4 NE 1/4 Section Number 4 Township Number T 25 S Range Number R 1 E
 County: SEDGWICK
 Distance and direction from nearest town or city street address of well if located within city? 1433 E. BYAWOOD - ~~12th St~~ Valley Center

2 WATER WELL OWNER: SAM ENTRAKE
 RR#, St. Address, Box #: P.O. Box 392
 City, State, ZIP Code: VALLEY CENTER, KS. 67147
 Board of Agriculture, Division of Water Resources
 Application Number:

3 LOCATE WELL'S LOCATION WITH AN "X" IN SECTION BOX: 4 DEPTH OF COMPLETED WELL: 50 ft. ELEVATION: 11-0-87

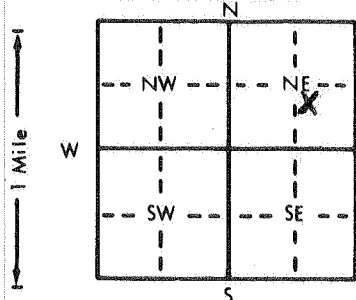

Depth(s) Groundwater Encountered 1. 24 ft. 2. 24 ft. 3. 24 ft.
 WELL'S STATIC WATER LEVEL 24 ft. below land surface measured on mo/day/yr 11-0-87
 Pump test data: Well water was 30 ft. after 1/2 hours pumping 20 gpm
 Est. Yield 20-25 gpm: Well water was 30 ft. after 1/2 hours pumping 20 gpm
 Bore Hole Diameter 11 in. to 50 ft., and 50 in. to 50 ft.
 WELL WATER TO BE USED AS:
☒ 1 Domestic ☐ 3 Feedlot ☐ 6 Oil field water supply ☐ 9 Dewatering ☐ 12 Other (Specify below)
☐ 2 Irrigation ☐ 4 Industrial ☐ 7 Lawn and garden only ☐ 10 Observation well
 Was a chemical/bacteriological sample submitted to Department? Yes X No X; If yes, mo/day/yr sample was submitted 11-0-87
 Water Well Disinfected? Yes X No X

5 TYPE OF BLANK CASING USED:
 1 Steel ☐ 3 RMP (SR) ☒ 5 Wrought iron ☐ 8 Concrete tile ☐ CASING JOINTS: Glued X Clamped X
 2 PVC ☐ 4 ABS ☐ 6 Asbestos-Cement ☐ 9 Other (specify below) Welded
 7 Fiberglass ☐ Threaded 11-0-87

Blank casing diameter 5 in. to 50 ft., Dia 1.59 in. to 50 ft., Dia 1.59 in. to 50 ft.
 Casing height above land surface 12 in., weight 1.59 lbs./ft. Wall thickness or gauge No. SPR-216

TYPE OF SCREEN OR PERFORATION MATERIAL:
 1 Steel ☐ 3 Stainless steel ☐ 5 Fiberglass ☐ 7 PVC ☐ 10 Asbestos-cement ☐
 2 Brass ☐ 4 Galvanized steel ☐ 6 Concrete tile ☐ 8 RMP (SR) ☒ 11 Other (specify) 11-0-87
 9 ABS ☐ 12 None used (open hole) 11-0-87

SCREEN OR PERFORATION OPENINGS ARE:
 1 Continuous slot ☐ 3 Mill slot ☒ 5 Gauzed wrapped ☐ 8 Saw cut ☐ 11 None (open hole) 11-0-87
 2 Louvered shutter ☐ 4 Key punched ☐ 6 Wire wrapped ☐ 9 Drilled holes ☐ 10 Other (specify) 11-0-87
 7 Torch cut ☐ 10 Other (specify) 11-0-87


6 GROUT MATERIAL: 1 Neat cement ☐ 2 Cement grout ☒ 3 Bentonite ☐ 4 Other ☐

What is the nearest source of possible contamination:
 1 Septic tank ☐ 4 Lateral lines ☐ 7 Pit privy ☐ 10 Livestock pens ☐ 14 Abandoned water well ☐
 2 Sewer lines ☐ 5 Cess pool ☐ 8 Sewage lagoon ☒ 11 Fuel storage ☐ 15 Oil well/Gas well ☐
 3 Watertight sewer lines ☐ 6 Seepage pit ☐ 9 Feedyard ☐ 12 Fertilizer storage ☐ 16 Other (specify below) 11-0-87
 13 Insecticide storage ☐

Direction from well? South How many feet? 135

FROM	TO	LITHOLOGIC LOG	FROM	TO	LITHOLOGIC LOG
0	2	top soil			
2	14	clay			
14	23	fine sand			
23	27	clay			
27	35	fine to med sand			
35	50	gray shale			

7 CONTRACTOR'S OR LANDOWNER'S CERTIFICATION: This water well was ☒ (1) constructed ☐ (2) reconstructed, or ☐ (3) plugged under my jurisdiction and was completed on (mo/day/year) Nov 16 1987 and this record is true to the best of my knowledge and belief. Kansas Water Well Contractor's License No. 318 This Water Well Record was completed on (mo/day/yr) Nov 19 1987 under the business name of WENINGER DRILLING by (signature) Jerome Weninger

INSTRUCTIONS: Use typewriter or ball point pen. PLEASE PRESS FIRMLY and PRINT clearly. Please fill in blanks, underline or circle the correct answers. Send top three copies to Kansas Department of Health and Environment, Bureau of Water Protection, Topeka, Kansas 66620-7320, Telephone: 913-862-9360. Send one to WATER WELL OWNER and retain one for your records.