


1 LOCATION OF WATER WELL: Fraction NE 1/4 SE 1/4 NE 1/4 Section Number 4 Township Number 25 S Range Number 1 E/W
 County: Sedgwick
 Distance and direction from nearest town or city street address of well if located within city?

1520 E. RYAN Rd. Sedgwick KS.

2 WATER WELL OWNER: DAVE PATTER
 RR#, St. Address, Box #: 1117 PORTER
 City, State, ZIP Code: WICHITA KS 67203
 Board of Agriculture, Division of Water Resources
 Application Number:

3 LOCATE WELL'S LOCATION WITH AN "X" IN SECTION BOX:

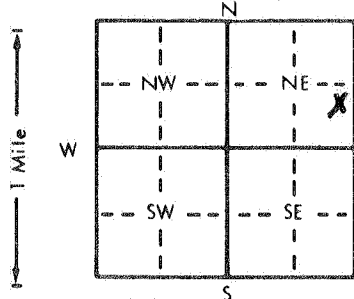

4 DEPTH OF COMPLETED WELL: 65 ft. ELEVATION:

Depth(s) Groundwater Encountered 1. 27 ft. 2. 25 ft. 3. 20 ft.

WELL'S STATIC WATER LEVEL 18 ft. below land surface measured on mo/day/yr 6-12-90

Pump test data: Well water was 20-30 gpm. Well water was 25 ft. after 1/2 hours pumping 20 gpm

Est. Yield 20-30 gpm. Well water was 25 ft. after 1/2 hours pumping 20 gpm

Bore Hole Diameter 11 in. to 6.5 ft., and 6.5 in. to 6.5 ft.

WELL WATER TO BE USED AS:

1 Domestic 3 Feedlot 6 Oil field water supply 8 Air conditioning 11 Injection well

2 Irrigation 4 Industrial 7 Lawn and garden only 9 Dewatering 12 Other (Specify below)

Was a chemical/bacteriological sample submitted to Department? Yes No X If yes, mo/day/yr sample was submitted

Water Well Disinfected? Yes X No

5 TYPE OF BLANK CASING USED:

1 Steel 3 RMP (SR) 5 Wrought iron 8 Concrete tile CASING JOINTS: Glued X Clamped

2 PVC 4 ABS 6 Asbestos-Cement 9 Other (specify below) Welded

Blank casing diameter 5 in. to 37 ft., Dia 37 in. to 65 ft., Dia 65 in. to 65 ft.

Casing height above land surface 12 in., weight 254 lbs./ft. Wall thickness or gauge No. 160 RSE

TYPE OF SCREEN OR PERFORATION MATERIAL:

1 Steel 3 Stainless steel 5 Fiberglass 8 RMP (SR) 10 Asbestos-cement

2 Brass 4 Galvanized steel 6 Concrete tile 9 ABS 11 Other (specify)

SCREEN OR PERFORATION OPENINGS ARE:

1 Continuous slot 2 Mill slot 5 Gauzed wrapped 8 Saw cut 11 None (open hole)

2 Louvered shutter 4 Key punched 6 Wire wrapped 9 Drilled holes

SCREEN-PERFORATED INTERVALS: From 37 ft. to 65 ft., From 37 ft. to 65 ft., From 37 ft. to 65 ft.

GRAVEL PACK INTERVALS: From 23 ft. to 65 ft., From 23 ft. to 65 ft., From 23 ft. to 65 ft.

6 GROUT MATERIAL:

1 Neat cement 2 Cement grout 3 Bentonite 4 Other

Grout Intervals: From 3 ft. to 23 ft., From 3 ft. to 23 ft., From 3 ft. to 23 ft.

What is the nearest source of possible contamination:

1 Septic tank 4 Lateral lines 7 Pit privy 10 Livestock pens 14 Abandoned water well

2 Sewer lines 5 Cess pool 8 Sewage lagoon 11 Fuel storage 15 Oil well/Gas well

3 Watertight sewer lines 6 Seepage pit 9 Feedyard 12 Fertilizer storage 16 Other (specify below)

Direction from well? South How many feet? 80

FROM TO LITHOLOGIC LOG FROM TO PLUGGING INTERVALS

0 2 Top so. 1 35 38 med sand

2 11 clay 38 65 charcoal shale

11 18 fine sand

18-23 clay

23 34 fine sand

34 35 clay

7 CONTRACTOR'S OR LANDOWNER'S CERTIFICATION: This water well was (1) constructed, (2) reconstructed, or (3) plugged under my jurisdiction and was

completed on (mo/day/year) 6-12-90 and this record is true to the best of my knowledge and belief. Kansas

Water Well Contractor's License No. 318 This Water Well Record was completed on (mo/day/yr) 6-12-90

under the business name of Wenger, Dull by (signature) [Signature]