

1 LOCATION OF WATER WELL: Fraction: NW 1/4 SW 1/4 NE 1/4 Section Number: 4 Township Number: T 25 S Range Number: R 1 E/W

County: Sedgwick Distance and direction from nearest town or city/street address of well if located within city?

6 1/2 E Sedgwick KS

2 WATER WELL OWNER:

RR#, St. Address, Box #:


City, State, ZIP Code:

Randy LONG  
1300 E. Glocker Rd.  
Sedgwick KS 67135

Board of Agriculture, Division of Water Resources

Application Number:

3 LOCATE WELL'S LOCATION WITH AN "X" IN SECTION BOX:

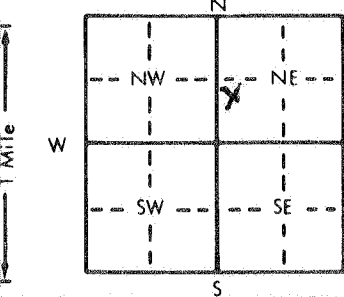

4 DEPTH OF COMPLETED WELL: 50 ft. ELEVATION:

Depth(s) Groundwater Encountered 1. 16 ft. 2. 12 ft. 3. 6-10-90 ft.

WELL'S STATIC WATER LEVEL 12 ft. below land surface measured on mo/day/yr 6-10-90

Pump test data: Well water was 20 ft. after 12 hours pumping 20 gpm

Est. Yield 25-35 gpm: Well water was 20 ft. after 12 hours pumping 20 gpm

Bore Hole Diameter: 11 in. to 50 ft., and 50 in. to 50 ft.

WELL WATER TO BE USED AS: 5 Public water supply 8 Air conditioning 11 Injection well

1 Domestic 3 Feedlot 6 Oil field water supply 9 Dewatering 12 Other (Specify below)

2 Irrigation 4 Industrial 7 Lawn and garden only 10 Monitoring well

Was a chemical/bacteriological sample submitted to Department? Yes X No X If yes, mo/day/yr sample was submitted

Water Well Disinfected? Yes X No X

5 TYPE OF BLANK CASING USED:

1 Steel 3 RMP (SR) 5 Wrought iron 8 Concrete tile CASING JOINTS: Glued X Clamped X

2 PVC 4 ABS 6 Asbestos-Cement 9 Other (specify below) Welded X

Blank casing diameter 5 in. to 16 ft., Dia 1.59 in. to 50 ft., Dia 50 in. to 50 ft.

Casing height above land surface 12 in., weight 1.59 lbs./ft. Wall thickness or gauge No. 50R-26

TYPE OF SCREEN OR PERFORATION MATERIAL:

1 Steel 3 Stainless steel 5 Fiberglass 8 RMP (SR) 10 Asbestos-cement

2 Brass 4 Galvanized steel 6 Concrete tile 9 ABS 11 Other (specify)

SCREEN OR PERFORATION OPENINGS ARE: 5 Gauzed wrapped 8 Saw cut 11 None (open hole)

1 Continuous slot 3 Mill slot 6 Wire wrapped 9 Drilled holes

2 Louvered shutter 4 Key punched 7 Torch cut 10 Other (specify)

SCREEN-PERFORATED INTERVALS: From 16 ft. to 50 ft., From 16 ft. to 50 ft.

GRAVEL PACK INTERVALS: From 15 ft. to 50 ft., From 15 ft. to 50 ft.

From 15 ft. to 50 ft., From 15 ft. to 50 ft.

From 15 ft. to 50 ft., From 15 ft. to 50 ft.

6 GROUT MATERIAL: 1 Neat cement 2 Cement grout 3 Bentonite 4 Other

Grout Intervals: From 3 ft. to 15 ft., From 15 ft. to 50 ft., From 15 ft. to 50 ft.

What is the nearest source of possible contamination:

1 Septic tank 4 Lateral lines 7 Pit privy 10 Livestock pens 14 Abandoned water well

2 Sewer lines 5 Cess pool 8 Sewage lagoon 11 Fuel storage 15 Oil well/Gas well

3 Watertight sewer lines 6 Seepage pit 9 Feedyard 12 Fertilizer storage 16 Other (specify below)

13 Insecticide storage

Direction from well? South How many feet? 75

FROM	TO	LITHOLOGIC LOG	FROM	TO	PLUGGING INTERVALS
0	2	Top 50: 1.			
2	16	clay			
16	28	sand			
28	50	charcoal shale			

7 CONTRACTOR'S OR LANDOWNER'S CERTIFICATION: This water well was (1) constructed, (2) reconstructed, or (3) plugged under my jurisdiction and was completed on (mo/day/year) 6-10-90 and this record is true to the best of my knowledge and belief. Kansas

Water Well Contractor's License No. 6318 this Water Well Record was completed on (mo/day/yr) 7-2-90

under the business name of Weninger Dully by (signature) [Signature]