


1 LOCATION OF WATER WELL: County: Sedgwick Fraction: SW 1/4 NE 1/4 NE 1/4 Section Number: 7 Township Number: T 25 S Range Number: R 10 E/W

Distance and direction from nearest town or city street address of well if located within city? 1 East of 5 miles North Valley Center,

2 WATER WELL OWNER: ~~Intertec~~ Jerry Lange
 RR#, St. Address, Box #: 1531 Valley View Ct
 City, State, ZIP Code: WICHITA KS 67217
 Board of Agriculture, Division of Water Resources
 Application Number:

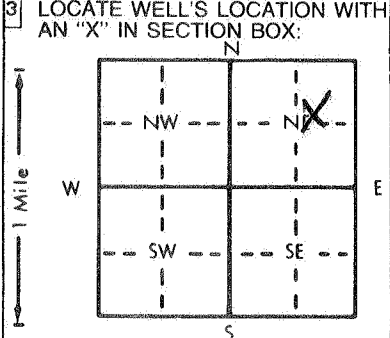

4 DEPTH OF COMPLETED WELL: 87 ft. ELEVATION: ft.
 Depth(s) Groundwater Encountered 1. 9 ft. 2. ft. 3. ft.
 WELL'S STATIC WATER LEVEL: 9 ft. below land surface measured on mo/day/yr 12-5-93
 Pump test data: Well water was ft. after hours pumping gpm
 Est. Yield 5-7 gpm: Well water was ft. after hours pumping gpm
 Bore Hole Diameter: in. to ft., and in. to ft.
 WELL WATER TO BE USED AS:
 1 Domestic 3 Feedlot 6 Oil field water supply 9 Dewatering 12 Other (Specify below)
 2 Irrigation 4 Industrial 7 Lawn and garden only 10 Monitoring well
 Was a chemical/bacteriological sample submitted to Department? Yes.....No ; If yes, mo/day/yr sample was submitted
 Water Well Disinfected? Yes No

5 TYPE OF BLANK CASING USED:
 1 Steel 3 RMP (SR) 5 Wrought iron 8 Concrete tile CASING JOINTS: Glued Clamped
 2 PVC 4 ABS 6 Asbestos-Cement 9 Other (specify below) Welded
 5 Fiberglass Threaded
 Blank casing diameter 5 in. to 27 ft., Dia. in. to ft., Dia. in. to ft.
 Casing height above land surface: 12 in., weight 2.60 lbs./ft. Wall thickness or gauge No. 160PVC
 TYPE OF SCREEN OR PERFORATION MATERIAL:
 1 Steel 3 Stainless steel 5 Fiberglass 7 PVC 10 Asbestos-cement
 2 Brass 4 Galvanized steel 6 Concrete tile 9 ABS 11 Other (specify)
 12 None used (open hole)
 SCREEN OR PERFORATION OPENINGS ARE:
 1 Continuous slot 3 Mill slot 5 Gauzed wrapped 8 Saw cut 11 None (open hole)
 2 Louvered shutter 4 Key punched 6 Wire wrapped 9 Drilled holes
 7 Torch cut 10 Other (specify)
 SCREEN-PERFORATED INTERVALS: From 27 ft. to 87 ft., From ft. to ft.
 From ft. to ft., From ft. to ft.
 GRAVEL PACK INTERVALS: From 23 ft. to 87 ft., From ft. to ft.
 From ft. to ft., From ft. to ft.

6 GROUT MATERIAL: 1 Neat cement 2 Cement grout 3 Bentonite 4 Other
 Grout Intervals: From 3 ft. to 23 ft., From ft. to ft., From ft. to ft.
 What is the nearest source of possible contamination:
 1 Septic tank 4 Lateral lines 7 Pit privy 10 Livestock pens 14 Abandoned water well
 2 Sewer lines 5 Cess pool 8 Sewage lagoon 11 Fuel storage 15 Oil well/Gas well
 3 Watertight sewer lines 6 Seepage pit 9 Feedyard 12 Fertilizer storage 16 Other (specify below)
 13 Insecticide storage
 Direction from well? open field How many feet?

| FROM | TO | LITHOLOGIC LOG | FROM | TO | PLUGGING INTERVALS |
|------|----|----------------|------|----|--------------------|
| 0 | 3 | top soil | | | |
| 3 | 10 | clay | | | |
| 10 | 13 | sand | | | |
| 13 | 20 | green shale | | | |
| 20 | 51 | blue shale | | | |
| 51 | 87 | blue clay | | | |

7 CONTRACTOR'S OR LANDOWNER'S CERTIFICATION: This water well was (1) constructed, (2) reconstructed, or (3) plugged under my jurisdiction and was completed on (mo/day/year) 1-5-93 and this record is true to the best of my knowledge and belief. Kansas Water Well Contractor's License No. 1318 This Water Well Record was completed on (mo/day/yr) 1-15-93 under the business name of Weninger Drilling, Inc. by (signature) Juan K Weninger