


1 LOCATION OF WATER WELL: County: Sedgewick Fraction: SW 1/4 SW 1/4 NW 1/4 Section Number: 9 Township Number: T 25 S Range Number: R 1 E

Distance and direction from nearest town or city street address of well if located within city?

11650 No Broadway

2 WATER WELL OWNER: Earl Speight
 RR#, St. Address, Box #: 930 No Hillside # 11
 City, State, ZIP Code: Wichita, KS 67219
 Board of Agriculture, Division of Water Resource
 Application Number:

3 LOCATE WELL'S LOCATION WITH AN "X" IN SECTION BOX:

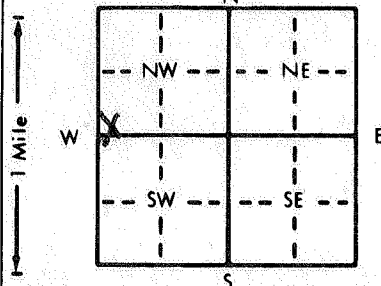

4 DEPTH OF COMPLETED WELL: 50 ft. ELEVATION:

Depth(s) Groundwater Encountered 1. 18.8 ft. 2. 20 ft. 3. 20 ft.
 WELL'S STATIC WATER LEVEL 18.8 ft. below land surface measured on 5-16-87
 Pump test data: Well water was 20 ft. after 2 hours pumping 20 gpm
 Est. Yield 30 gpm: Well water was 20 ft. after 2 hours pumping 20 gpm
 Bore Hole Diameter 11 in. to 50 ft., and 50 in. to 50 ft.
 WELL WATER TO BE USED AS:
 1 Domestic 3 Feedlot 6 Oil field water supply 9 Dewatering 12 Other (Specify below)
 2 Irrigation 4 Industrial 7 Lawn and garden only 10 Observation well

Was a chemical/bacteriological sample submitted to Department? Yes X No X; If yes, mo/day/yr sample was submitted

5 TYPE OF BLANK CASING USED:
 1 Steel 3 RMP (SR)
 2 PVC 4 ABS
 5 Wrought iron 8 Concrete tile CASING JOINTS: Glued X Clamped X
 6 Asbestos-Cement 9 Other (specify below) Welded X
 7 Fiberglass Threaded X

Blank casing diameter 5 in. to 25 ft., Dia 5 in. to 25 ft., Dia 5 in. to 25 ft.
 Casing height above land surface 12 in., weight 1.59 lbs./ft. Wall thickness or gauge No. SOR-26

TYPE OF SCREEN OR PERFORATION MATERIAL:
 1 Steel 3 Stainless steel 5 Fiberglass 7 PVC 10 Asbestos-cement
 2 Brass 4 Galvanized steel 6 Concrete tile 8 RMP (SR) 11 Other (specify)
 9 ABS 12 None used (open hole)

SCREEN OR PERFORATION OPENINGS ARE:
 1 Continuous slot 3 Mill slot 5 Gauzed wrapped 8 Saw cut 11 None (open hole)
 2 Louvered shutter 4 Key punched 6 Wire wrapped 9 Drilled holes
 7 Torch cut 10 Other (specify)

SCREEN-PERFORATED INTERVALS: From 25 ft. to 50 ft., From 25 ft. to 50 ft., From 25 ft. to 50 ft.
 GRAVEL PACK INTERVALS: From 13 ft. to 50 ft., From 13 ft. to 50 ft., From 13 ft. to 50 ft.

6 GROUT MATERIAL: 1 Neat cement 2 Cement grout 3 Bentonite 4 Other
 Grout Intervals: From 3 ft. to 13 ft., From 3 ft. to 13 ft., From 3 ft. to 13 ft., From 3 ft. to 13 ft.

What is the nearest source of possible contamination:
 1 Septic tank 4 Lateral lines 7 Pit privy 10 Livestock pens 14 Abandoned water well
 2 Sewer lines 5 Cess pool 8 Sewage lagoon 11 Fuel storage 15 Oil well/Gas well
 3 Watertight sewer lines 6 Seepage pit 9 Feedyard 12 Fertilizer storage 16 Other (specify below)
 13 Insecticide storage

Direction from well? EAST How many feet? 90

FROM	TO	LITHOLOGIC LOG	FROM	TO	LITHOLOGIC LOG
0	2	Top soil			
2	14	clay			
14	34	Sand			
34	50	shale			

7 CONTRACTOR'S OR LANDOWNER'S CERTIFICATION: This water well was (1) constructed, (2) reconstructed, or (3) plugged under my jurisdiction and was completed on (mo/day/year) 5-16-87 and this record is true to the best of my knowledge and belief. Kansas Water Well Contractor's License No. 318 This Water Well Record was completed on (mo/day/yr) 5-20-87 under the business name of Weninger Drilling by (signature) [Signature]