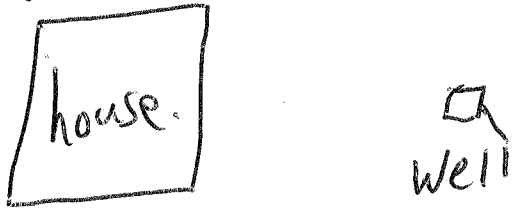


USE TYPEWRITER OR BALL POINT PEN—PRESS FIRMLY, PRINT CLEARLY.

WATER WELL RECORD
KSA 82a-1201-1215

Kansas Department of Health and Environment—Division of Environment
(Water well Contractors)
Topeka, Kansas 66620

1. Location of well:		County Sedg.	Fraction SE 1/4 SW 1/4 SW 1/4	Section number 13	Township number T 25 S R 1 E W	Range number
2. Distance and direction from nearest town or city: Street address of well location if in city: 1 1/4 miles east of Sunnysdale Ks				3. Owner of well: Ernest Rhoades. R.R. or street: R#2 City, state, zip code: Valley Center Ks 67117		
4. Locate with "X" in section below: N W E S 1 Mile				Sketch map: 		6. Bore hole dia. 4 in. Completion date 11/14/77 Well depth 78 ft.
5. Type and color of material				From	To	7. <input type="checkbox"/> Cable tool <input checked="" type="checkbox"/> Rotary <input type="checkbox"/> Driven <input type="checkbox"/> Dug <input type="checkbox"/> Hollow rod <input type="checkbox"/> Jetted <input type="checkbox"/> Bored <input type="checkbox"/> Reverse rotary
Top soil				0	3	8. Use: <input checked="" type="checkbox"/> Domestic <input type="checkbox"/> Public supply <input type="checkbox"/> Industry <input type="checkbox"/> Irrigation <input type="checkbox"/> Air conditioning <input checked="" type="checkbox"/> Stock <input checked="" type="checkbox"/> Lawn <input type="checkbox"/> Oil field water <input type="checkbox"/> Other
white rockish clay.				3	18	9. Casing: Material <input checked="" type="checkbox"/> X Height Above or below Threaded <input type="checkbox"/> Welded <input checked="" type="checkbox"/> Surface 1 1/2 in. RMP <input type="checkbox"/> PVC <input checked="" type="checkbox"/> Weight 231 lbs./ft. Dia. 3 in. to 28 ft. depth Wall thickness: inches or Dia. <input type="checkbox"/> in. to <input type="checkbox"/> ft. depth gage No. 4214
med to fine sand.				18	34	10. Screen: Manufacturer's name MPI Type PVC Dia. 5/8 Slot/gauze 1/4 Length 34 ft. Set between 4 ft. and 78 ft. ft. and <input type="checkbox"/> ft. Gravel pack? yes Size range of material 3/8
brownish rock				34	49	11. Static water level: 26 ft. below land surface Date 11/14/77 mg./day/yr.
limestone				50	51	12. Pumping level below land surfaces: 32 ft. after 1/2 hrs. pumping 15 g.p.m. <input type="checkbox"/> ft. after <input type="checkbox"/> hrs. pumping <input type="checkbox"/> g.p.m. Estimated maximum yield 20-25 g.p.m.
Blue clay.				51	68	13. Water sample submitted: <input type="checkbox"/> Yes <input checked="" type="checkbox"/> No Date <input type="checkbox"/>
Charcoal shale.				68	78	14. Well head completion: <input type="checkbox"/> Pitless adapter 12 inches above grade
Customer to furnish 4x4x4 reinforced slab at surface of well				15. Well grouted? yes With: <input checked="" type="checkbox"/> Neat cement <input type="checkbox"/> Bentonite <input type="checkbox"/> Concrete Depth: From 3 ft. to 13 ft.		
				16. Nearest source of possible contamination: None ft. Direction None Well disinfected upon completion? <input checked="" type="checkbox"/> Yes <input type="checkbox"/> No		
18. Elevation:				17. Pump: <input checked="" type="checkbox"/> Not installed Manufacturer's name <input type="checkbox"/> Model number <input type="checkbox"/> HP <input type="checkbox"/> Volts <input type="checkbox"/> Length of drop pipe <input type="checkbox"/> ft. capacity <input type="checkbox"/> g.p.m. Type: <input type="checkbox"/> Submersible <input type="checkbox"/> Turbine <input type="checkbox"/> Jet <input type="checkbox"/> Reciprocating <input type="checkbox"/> Centrifugal <input type="checkbox"/> Other		

Forward the white, blue and pink copies to the Department of Health and Environment

Form WWC-5