


1 LOCATION OF WATER WELL: County: Sedgwick Fraction: NW 1/4 NE 1/4 NW 1/4 Section Number: 14 Township Number: T 25 S Range Number: R 1E EW

Distance and direction from nearest town or city street address of well if located within city? 3601 E. 109th N. Kechi, Ks.

2 WATER WELL OWNER: Barkley, Chuck RR#, St. Address, Box #: 3601 E. 109th N. City, State, ZIP Code: Kechi, Kansas Board of Agriculture, Division of Water Resource Application Number:

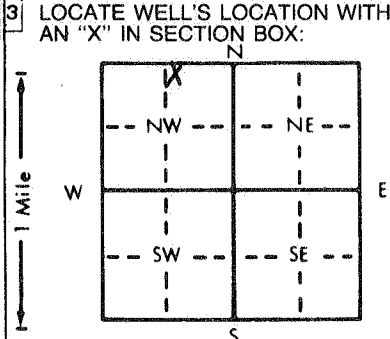

3 LOCATE WELL'S LOCATION WITH AN 'X' IN SECTION BOX: 4 DEPTH OF COMPLETED WELL: 65 ft. ELEVATION: 10 ft. below land surface measured on 12-17-91

5 TYPE OF BLANK CASING USED: 1 Steel, 2 PVC, 3 RMP (SR), 4 ABS, 5 Wrought iron, 6 Asbestos-Cement, 7 Fiberglass, 8 Concrete tile, 9 Other (specify below) SDR-26, 10 Asbestos-cement, 11 Injection well, 12 Other (Specify below)

6 GROUT MATERIAL: 1 Neat cement, 2 Cement grout, 3 Bentonite, 4 Other. Grout Intervals: From 4 ft. to 24 ft. What is the nearest source of possible contamination: 1 Septic tank, 2 Sewer lines, 3 Watertight sewer lines, 4 Lateral lines, 5 Cess pool, 6 Seepage pit, 7 Pit privy, 8 Sewage lagoon, 9 Feedyard, 10 Livestock pens, 11 Fuel storage, 12 Fertilizer storage, 13 Insecticide storage, 14 Abandoned water well, 15 Oil well/Gas well, 16 Other (specify below) None Apparent.

Direction from well? FROM TO LITHOLOGIC LOG FROM TO PLUGGING INTERVALS

FROM	TO	LITHOLOGIC LOG	FROM	TO	PLUGGING INTERVALS
0	3	topsoil			
3	11	clay			
11	33	fine sand			
33	65	grey shale			

7 CONTRACTOR'S OR LANDOWNER'S CERTIFICATION: This water well was (1) constructed, (2) reconstructed, or (3) plugged under my jurisdiction and was completed on (mo/day/year) 12-17-91 and this record is true to the best of my knowledge and belief. Kansas Water Well Contractor's License No. 236. This Water Well Record was completed on (mo/day/yr) 2-18-92 under the business name of Harp Well and Pump Service, Inc. by (signature) Mary Arnold