


1 LOCATION OF WATER WELL: County: Edgewood Fraction: SE 1/4 SW 1/4 SE 1/4 Section Number: 17 Township Number: T 25 S Range Number: R 1 E
 Distance and direction from nearest town or city street address of well if located within city? See Below

2 WATER WELL OWNER: Robert Haley Board of Agriculture, Division of Water Resources
 RR#, St. Address, Box #: 300 W. 101st + North Application Number:
 City, State, ZIP Code: VALLEY Center KS

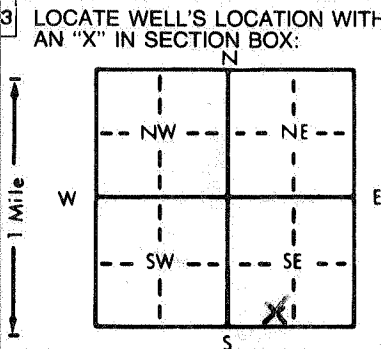

4 DEPTH OF COMPLETED WELL: 48 ft. ELEVATION:
 Depth(s) Groundwater Encountered 1. 17 ft. 2. 18 ft. 3. 20 ft.
 WELL'S STATIC WATER LEVEL: 17 ft. below land surface measured on 6-19-87 mo/day/yr
 Pump test data: Well water was 18 ft. after 1/2 hours pumping 20 gpm
 Est. Yield 25-30 gpm: Well water was 18 ft. after 1/2 hours pumping 20 gpm
 Bore Hole Diameter: 11 in. to 48 ft., and 11 in. to 48 ft.
 WELL WATER TO BE USED AS:
 Domestic 3 Feedlot 6 Oil field water supply 9 Dewatering 12 Other (Specify below)
 2 Irrigation 4 Industrial 7 Lawn and garden only 10 Observation well
 Was a chemical/bacteriological sample submitted to Department? Yes X No X; If yes, mo/day/yr sample was submitted
 Water Well Disinfected? Yes X No X

5 TYPE OF BLANK CASING USED:
 1 Steel 3 RMP (SR) 5 Wrought iron 8 Concrete tile CASING JOINTS: Glued X Clamped X
 2 PVC 4 ABS 6 Asbestos-Cement 9 Other (specify below) Welded X
 7 Fiberglass Threaded X
 Casing height above land surface: 12 in., weight 159 lbs./ft. Wall thickness or gauge No. SDR-26
 TYPE OF SCREEN OR PERFORATION MATERIAL:
 1 Steel 3 Stainless steel 5 Fiberglass 7 PVC 10 Asbestos-cement
 2 Brass 4 Galvanized steel 6 Concrete tile 8 RMP (SR) 11 Other (specify)
 9 ABS 12 None used (open hole)
 SCREEN OR PERFORATION OPENINGS ARE:
 1 Continuous slot 3 Mill slot 5 Gauzed wrapped 8 Saw cut 11 None (open hole)
 2 Louvered shutter 4 Key punched 6 Wire wrapped 9 Drilled holes
 7 Torch cut 10 Other (specify)

 What is the nearest source of possible contamination:
 1 Septic tank 4 Lateral lines 7 Pit privy 10 Livestock pens 14 Abandoned water well
 2 Sewer lines 5 Cess pool 8 Sewage lagoon 11 Fuel storage 15 Oil well/Gas well
 3 Watertight sewer lines 6 Seepage pit 9 Feedyard 12 Fertilizer storage 16 Other (specify below)
 13 Insecticide storage
 Direction from well? NE How many feet? 120

| FROM | TO | LITHOLOGIC LOG | FROM | TO | LITHOLOGIC LOG |
|------|----|-------------------|------|----|----------------|
| 0 | 2 | Top soil | | | |
| 2 | 18 | Clay | | | |
| 18 | 39 | Fine to med sand | | | |
| 39 | 48 | shale & gray clay | | | |

7 CONTRACTOR'S OR LANDOWNER'S CERTIFICATION: This water well was (1) constructed, (2) reconstructed, or (3) plugged under my jurisdiction and was completed on (mo/day/year) 6-19-87 and this record is true to the best of my knowledge and belief. Kansas Water Well Contractor's License No. 318 This Water Well Record was completed on (mo/day/yr) 6-19-87 under the business name of Wenger's Drilling by (signature) [Signature]

INSTRUCTIONS: Use typewriter or ball point pen. PLEASE PRESS FIRMLY and PRINT clearly. Please fill in blanks, underline or circle the correct answers. Send top three copies to Kansas Department of Health and Environment, Office of Oil Field and Environmental Geology, Regulation and Permitting Section, Topeka, Kansas 66620-7500, Telephone: 913-862-9360. Send one to WATER WELL OWNER and retain one for your records.