

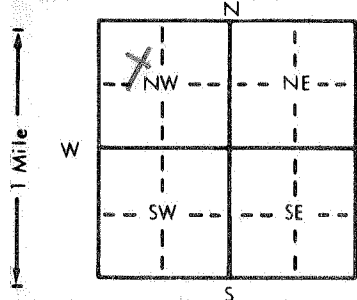
1 LOCATION OF WATER WELL: County: <u>SEDGWICK</u>	Fraction <u>SE 1/4 NW 1/4 NW 1/4</u>	Section Number <u>22</u>	Township Number <u>T 25 S</u>	Range Number <u>R 1 EW</u>
--	---	-----------------------------	----------------------------------	-------------------------------

Distance and direction from nearest town or city street address of well if located within city?

1/4 E of R35 on 101st North then S so many feet

2 WATER WELL OWNER: RR#, St. Address, Box #: City, State, ZIP Code	<u>Ray Boose</u> <u>1525 E SHUNY DALE</u> <u>VALLEY CENTER, KS</u>	Board of Agriculture, Division of Water Resources Application Number:
--	--	--

3 LOCATE WELL'S LOCATION WITH AN "X" IN SECTION BOX:	4 DEPTH OF COMPLETED WELL: <u>61</u> ft. ELEVATION:
--	---

Depth(s) Groundwater Encountered 1. 50 ft. 2. ft. 3. ft.WELL'S STATIC WATER LEVEL 20 ft. below land surface measured on mo/day/yr

Pump test data: Well water was ft. after hours pumping gpm

Est. Yield 50 gpm: Well water was ft. after hours pumping gpmBore Hole Diameter 10 in. to ft., and in. to ft.

WELL WATER TO BE USED AS:

1 Domestic 3 Feedlot 6 Oil field water supply 9 Dewatering 12 Other (Specify below)

2 Irrigation 4 Industrial 7 Lawn and garden only 10 Observation well

Was a chemical/bacteriological sample submitted to Department? Yes.....No..... If yes, mo/day/yr sample was submitted

Water Well Disinfected? Yes.....No.....

5 TYPE OF BLANK CASING USED:	5 Wrought iron	8 Concrete tile	CASING JOINTS: <u>Glued</u> Clamped
1 Steel	3 RMP (SR)	6 Asbestos-Cement	9 Other (specify below)
<u>2 PVC</u>	4 ABS	7 Fiberglass	Welded
Blank casing diameter <u>5</u> in. to ft., Dia.	in. to ft., Dia.	in. to ft., Dia.	in. to ft., Dia.
Casing height above land surface <u>7.12</u> in., weight	lbs./ft. Wall thickness or gauge No.		

TYPE OF SCREEN OR PERFORATION MATERIAL:

1 Steel 3 Stainless steel 5 Fiberglass 7 PVC 10 Asbestos-cement

2 Brass 4 Galvanized steel 6 Concrete tile 8 RMP (SR) 11 Other (specify)

SCREEN OR PERFORATION OPENINGS ARE:

1 Continuous slot 3 Mill slot 5 Gauzed wrapped 8 Saw cut 11 None (open hole)

2 Louvered shutter 4 Key punched 6 Wire wrapped 9 Drilled holes

SCREEN-PERFORATED INTERVALS: From 41 ft. to 61 ft. From ft. to ft.GRAVEL PACK INTERVALS: From 20 ft. to 61 ft. From ft. to ft.

GROUT MATERIAL: 1 Neat cement 2 Cement grout 3 Bentonite 4 Other

Grout intervals: From 3 ft. to 20 ft. From ft. to ft.

What is the nearest source of possible contamination:

1 Septic tank 4 Lateral lines 7 Pit privy 10 Livestock pens 14 Abandoned water well

2 Sewer lines 5 Cess pool 8 Sewage lagoon 11 Fuel storage 15 Oil well/Gas well

3 Watertight sewer lines 6 Seepage pit 9 Feedyard 12 Fertilizer storage 16 Other (specify below)

Direction from well? How many feet? 750

FROM TO LITHOLOGIC LOG

FROM TO LITHOLOGIC LOG

7 CONTRACTOR'S OR LANDOWNER'S CERTIFICATION: This water well was (1) constructed, (2) reconstructed, or (3) plugged under my jurisdiction and was completed on (mo/day/year) 9/24/85 and this record is true to the best of my knowledge and belief. Kansas Water Well Contractor's License No. 4126/85 This Water Well Record was completed on (mo/day/year) 9/26/85 under the business name of REISENER WELL DRILLING by (signature) Jerry Reiser

INSTRUCTIONS: Use typewriter or ball point pen, PLEASE PRESS FIRMLY and PRINT clearly. Please fill in blanks, underline or circle the correct answers. Send top three copies to Kansas Department of Health and Environment, Division of Environment, Environmental Geology Section, Topeka, KS 66620. Send one to WATER WELL OWNER and retain one for your records.