


1 LOCATION OF WATER WELL: Sedgwick	FRACTION NE 1/4 SE 1/4 NE 1/4	Section Number 24	Township Number T 25 S	Range Number R 1E E/W
---	---	-----------------------------	----------------------------------	---------------------------------

Distance and direction from nearest town or city street address of well if located within city?

9955 N. Woodlawn Wichita, Kansas

2 WATER WELL OWNER: HOPPER, Rick RR#, ST. ADDRESS, BOX #: 9955 N. Woodlawn CITY, STATE, ZIP CODE: Wichita, Kansas	Board of Agriculture, Division of Water Resource Application Number:
---	---

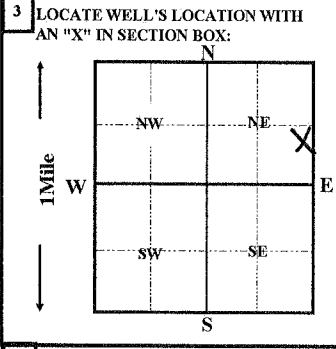

4 DEPTH OF COMPLETED WELL **95** ft. ELEVATION:

Depth(s) groundwater Encountered 1 ft. 2 ft. 3 ft.

WELL'S STATIC WATER LEVEL **12** FT. BELOW LAND SURFACE MEASURED ON **09/15/1993**
mo/day/yr

Pump test data: Well water was ft. after hours pumping gpm
Est. Yield gpm: Well water was ft. after hours pumping gpm

Bore Hole Diameter **12** in. to **95** ft., and in. to ft.

WELL WATER TO BE USED AS: 5 Public water supply 8 Air conditioning 11 Injection well
1 Domestic 3 Feedlot 6 Oil field water supply 9 Dewatering 12 Other (Specify below)
2 Irrigation 4 Industrial 7 Lawn and garden only 10 Monitoring well

Was a chemical/bacteriological sample submitted to Department? Yes No **X**; If yes, mo/day/yr sample was submitted Water Well Disinfected? Yes **X** No

5 TYPE OF CASING USED:

1 Steel	3 RMP (SR)	5 Wrought iron	8 Concrete tile	CASING JOINTS:	Glued X Clamped
2 PVC	4 ABS	6 Asbestos-Cement	9 Other (Specify below)		Welded
Blank casing Diameter 5 in. to 25 ft.; Dia in. to ft., Dia in. to ft.		7 Fiberglass	SDR-26		Threaded
Casing height above land surface 12 in., weight 2.35 lbs./ft. Wall thickness or gauge No. .214		TYPE OF SCREEN OR PERFORATION MATERIAL:			
1 Steel	3 Stainless Steel	5 Fiberglass	8 RMP (SR)	11 other (specify)	
2 Brass	4 Galvanized steel	6 Concrete tile	9 ABS	12 None used (open hole)	
SCREEN OR PERFORATION OPENING ARE:		5 Gauzed wrapped	8 Saw cut	11 None (open hole)	
1 Continuous slot	3 Mill slot	6 Wire wrapped	9 Drilled holes		
2 Louvered shutter	4 Key punched	7 Torch cut	10 Other (specify)		
SCREEN-PERFORATION INTERVALS: from 25 ft. to 95 ft., From ft. to ft.					
GRAVEL PACK INTERVALS: from 24 ft. to 95 ft., From ft. to ft.					

6 GROUT MATERIAL: 1 Neat cement 2 Cement grout 3 Bentonite 4 Other

Grout Intervals: From **4** ft. to **24** ft., From ft. to ft.

What is the nearest source of possible contamination:

1 Septic tank	4 Lateral lines	7 Pit privy	10 Livestock pens	14 Abandon water well
2 Sewer lines	5 Cess pool	8 Sewage lagoon	11 Fuel storage	15 Oil well/Gas well
3 Watertight sewer lines	6 Seepage pit	9 Feedyard	12 Fertilizer storage	16 Other (specify below)
None Apparent				

Direction from well? _____ How many feet? _____

FROM	TO	LITHOLOGIC LOG	FROM	TO	PLUGGING INTERVALS
0	3	topsoil			SEPTIC SYSTEM NOT INSTALLED AT THIS TIME
3	9	clay			
9	15	fine sand			
15	18	clay			
18	95	grey clay and shale			

7 CONTRACTOR'S OR LANDOWNER'S CERTIFICATION: This water well was (1) constructed, (2) reconstructed, or (3) plugged under my jurisdiction and was completed on (mo/day/year) **09/15/1993** and this record is true to the best of my knowledge and belief. Kansas Water Well Contractor's License No. **236** This Water Well Record was completed on (mo/day/yr) **11/05/93** Under the business name of **Harp Well & Pump Service, Inc** by (signature) *Jane Frederick*

778