


1 LOCATION OF WATER WELL: County: Sedgwick Fraction: NW 1/4 SW 1/4 NE 1/4 Section Number: 29 Township Number: T 25 S Range Number: R 1 E
 Distance and direction from nearest town or city street address of well if located within city?
500 LONG LANE

2 WATER WELL OWNER: RICHARD MANNING Board of Agriculture, Division of Water Resources
 RR#, St. Address, Box #: 500 LONG LANE Application Number:
 City, State, ZIP Code: WICHITA, KS 67204

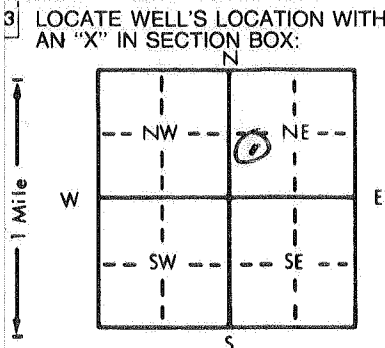

4 DEPTH OF COMPLETED WELL: 30 ft. ELEVATION:
 Depth(s) Groundwater Encountered 1. N/A ft. 2. ft. 3.
 WELL'S STATIC WATER LEVEL: 13 ft. below land surface measured on mo/day/yr 5-5-94
 Pump test data: Well water was N/A ft. after hours pumping gpm
 Est. Yield gpm: Well water was ft. after hours pumping gpm
 Bore Hole Diameter: in. to ft., and in. to ft.
 WELL WATER TO BE USED AS:
 1 Domestic 3 Feedlot 6 Oil field water supply 9 Dewatering 12 Other (Specify below)
 2 Irrigation 4 Industrial 7 Lawn and garden only 10 Observation well
 Was a chemical/bacteriological sample submitted to Department? Yes.....No.....; If yes, mo/day/yr sample was submitted
 Water Well Disinfected? Yes No

5 TYPE OF BLANK CASING USED:
 1 Steel 3 RMP (SR) 5 Wrought iron 8 Concrete tile CASING JOINTS: Glued Clamped
 2 PVC 4 ABS 6 Asbestos-Cement 9 Other (specify below) GALVANIZED (SAND PT) Welded
 7 Fiberglass Threaded
 Blank casing diameter: 1 1/4 in. to ft., Dia in. to ft., Dia in. to ft.
 Casing height above land surface: 0 in., weight lbs./ft. Wall thickness or gauge No.
 TYPE OF SCREEN OR PERFORATION MATERIAL:
 1 Steel 3 Stainless steel 5 Fiberglass 8 RMP (SR) 10 Asbestos-cement 11 Other (specify) N/A
 2 Brass 4 Galvanized steel 6 Concrete tile 9 ABS 12 None used (open hole)
 SCREEN OR PERFORATION OPENINGS ARE:
 1 Continuous slot 3 Mill slot 5 Gauzed wrapped 8 Saw cut 11 None (open hole)
 2 Louvered shutter 4 Key punched 6 Wire wrapped 9 Drilled holes
 7 Torch cut 10 Other (specify) N/A
 SCREEN-PERFORATED INTERVALS: From N/A ft. to N/A ft., From ft. to ft.
 GRAVEL PACK INTERVALS: From N/A ft. to N/A ft., From ft. to ft.

6 GROUT MATERIAL: 1 Neat cement 2 Cement grout 3 Bentonite 4 Other
 Grout Intervals: From 0 ft. to 30 ft., From ft. to ft., From ft. to ft.
 What is the nearest source of possible contamination:
 1 Septic tank 4 Lateral lines 7 Pit privy 10 Livestock pens 14 Abandoned water well
 2 Sewer lines 5 Cess pool 8 Sewage lagoon 11 Fuel storage 15 Oil well/Gas well
 3 Watertight sewer lines 6 Seepage pit 9 Feedyard 12 Fertilizer storage 16 Other (specify below)
 13 Insecticide storage
 Direction from well? W How many feet? 74'

FROM	TO	LITHOLOGIC LOG	FROM	TO	LITHOLOGIC LOG
			<u>0</u>	<u>30</u>	<u>NEAT CEMENT</u>
					<u>CHLORINATED</u>
					<u>REMOVED 5 ft Section</u>
					<u>FILLED TO TOP WITH</u>
					<u>NEAT CEMENT</u>

7 CONTRACTOR'S OR LANDOWNER'S CERTIFICATION: This water well was (1) constructed, (2) reconstructed, or (3) plugged under my jurisdiction and was completed on (mo/day/year) 5-5-94 and this record is true to the best of my knowledge and belief. Kansas Water Well Contractor's License No. 313 This Water Well Record was completed on (mo/day/yr) 5-20-94 under the business name of JET DRILLING by (signature) [Signature]