


1 LOCATION OF WATER WELL: Fraction NE 1/4 SE 1/4 NE 1/4 Section Number 30 Township Number T 25 S Range Number R 1 E/W  
 County: Sedgwick  
 Distance and direction from nearest town or city street address of well if located within city? 1 E 3/4 No Valley Center KS.

2 WATER WELL OWNER: John Haskit  
 RR#, St. Address, Box #: BIK 3A Board of Agriculture, Division of Water Resource  
 City, State, ZIP Code: Valley Center KS 67147 Application Number:

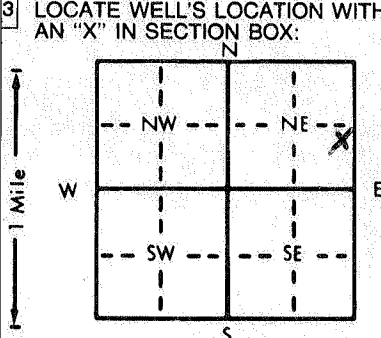

4 DEPTH OF COMPLETED WELL: 80 ft. ELEVATION:  
 Depth(s) Groundwater Encountered 1. 28 ft. 2. ft. 3. ft.  
 WELL'S STATIC WATER LEVEL 28 ft. below land surface measured on mo/day/yr 12-18-86  
 Pump test data: Well water was 40 ft. after 1/2 hours pumping 15 gpm  
 Est. Yield 10-15 gpm: Well water was ft. after hours pumping gpm  
 Bore Hole Diameter: 1 1/2 in. to 80 ft., and in. to ft.  
 WELL WATER TO BE USED AS:  
 1 Domestic  3 Feedlot  6 Oil field water supply  9 Dewatering  12 Other (Specify below)  
 2 Irrigation  4 Industrial  7 Lawn and garden only  10 Observation well  
 Was a chemical/bacteriological sample submitted to Department? Yes.....No .....; If yes, mo/day/yr sample was submitted  
 Water Well Disinfected? Yes  No

5 TYPE OF BLANK CASING USED:  
 1 Steel  3 RMP (SR) 5 Wrought iron 8 Concrete tile CASING JOINTS: Glued  Clamped.....  
 2 PVC 4 ABS 6 Asbestos-Cement 9 Other (specify below) Welded.....  
 7 Fiberglass Threaded.....  
 Blank casing diameter 5 in. to 26 ft., Dia. in. to ft., Dia. in. to ft.  
 Casing height above land surface 12 in., weight 1.59 lbs./ft. Wall thickness or gauge No. SOR-26  
 TYPE OF SCREEN OR PERFORATION MATERIAL:  
 1 Steel 3 Stainless steel 5 Fiberglass  8 RMP (SR) 10 Asbestos-cement 11 Other (specify)  
 2 Brass 4 Galvanized steel 6 Concrete tile 9 ABS 12 None used (open hole)  
 SCREEN OR PERFORATION OPENINGS ARE:  
 1 Continuous slot  3 Mill slot 5 Gauzed wrapped 8 Saw cut 11 None (open hole)  
 2 Louvered shutter 4 Key punched 6 Wire wrapped 9 Drilled holes  
 7 Torch cut 10 Other (specify)  
 SCREEN-PERFORATED INTERVALS: From 26 ft. to 80 ft., From ft. to ft.  
 From ft. to ft., From ft. to ft.  
 GRAVEL PACK INTERVALS: From 13 ft. to 80 ft., From ft. to ft.  
 From ft. to ft., From ft. to ft.

6 GROUT MATERIAL: 1 Neat cement 2 Cement grout  3 Bentonite 4 Other.....  
 Grout Intervals: From 3 ft. to 13 ft., From ft. to ft., From ft. to ft.  
 What is the nearest source of possible contamination:  
 1 Septic tank 4 Lateral lines 7 Pit privy 10 Livestock pens 14 Abandoned water well  
 2 Sewer lines 5 Cess pool 8 Sewage lagoon 11 Fuel storage 15 Oil well/Gas well  
 3 Watertight sewer lines 6 Seepage pit 9 Feedyard 12 Fertilizer storage 16 Other (specify below)  
 13 Insecticide storage  
 Direction from well? EAST How many feet? 80

FROM	TO	LITHOLOGIC LOG	FROM	TO	LITHOLOGIC LOG
0	2	Top soil			
2	24	Clay			
24	25	fine sand			
25	26	clay			
26	30	med sand			
30	80	Charcoal Shale			

7 CONTRACTOR'S OR LANDOWNER'S CERTIFICATION: This water well was  (1) constructed,  (2) reconstructed, or  (3) plugged under my jurisdiction and was completed on (mo/day/year) 12-18-86 and this record is true to the best of my knowledge and belief. Kansas Water Well Contractor's License No. 318 This Water Well Record was completed on (mo/day/yr) 12-18-86 under the business name of Weninger Drilling by (signature) [Signature]

INSTRUCTIONS: Use typewriter or ball point pen. PLEASE PRESS FIRMLY and PRINT clearly. Please fill in blanks, underline or circle the correct answers. Send top three copies to Kansas Department of Health and Environment, Office of Oil Field and Environmental Geology, Regulation and Permitting Section, Topeka, Kansas 66620-7500, Telephone: 913-862-9360. Send one to WATER WELL OWNER and retain one for your records.