


1 LOCATION OF WATER WELL: County: SEDGWICK Fraction: NW 1/4 SE 1/4 NE 1/4 Section Number: 30 Township Number: T 25 S Range Number: R 1 E

Distance and direction from nearest town or city street address of well if located within city?

1 E 3/4 N. Valley Center, KS.

2 WATER WELL OWNER: PAUL HARRISON Board of Agriculture, Division of Water Resources
 RR#, St. Address, Box #: 5500 N. MERIDIAN
 City, State, ZIP Code: WICHITA, KS 67204 Application Number:

3 LOCATE WELL'S LOCATION WITH AN "X" IN SECTION BOX:

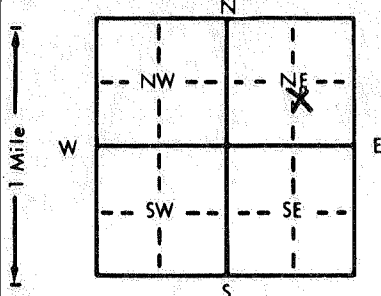

4 DEPTH OF COMPLETED WELL: 74 ft. ELEVATION:

Depth(s) Groundwater Encountered: 1. 26 ft. 2. 26 ft. 3. 5-15-87 ft.
 WELL'S STATIC WATER LEVEL: 26 ft. below land surface measured on mo/day/yr 5-15-87
 Pump test data: Well water was 35 ft. after 1/2 hours pumping 15 gpm
 Est. Yield: 12 gpm; Well water was 35 ft. after 1/2 hours pumping 15 gpm
 Bore Hole Diameter: 11 in. to 74 ft., and 11 in. to 74 ft.
 WELL WATER TO BE USED AS:
 1 Domestic 3 Feedlot 6 Oil field water supply 9 Dewatering 12 Other (Specify below)
 2 Irrigation 4 Industrial 7 Lawn and garden only 10 Observation well
 Was a chemical/bacteriological sample submitted to Department? Yes X No X; If yes, mo/day/yr sample was submitted

5 TYPE OF BLANK CASING USED:
 1 Steel 3 RMP (SR) 5 Wrought iron 8 Concrete tile CASING JOINTS: Glued X Clamped X
 2 PVC 4 ABS 6 Asbestos-Cement 9 Other (specify below) Welded
 7 Fiberglass Threaded

 Casing height above land surface: 12 in., weight 1.59 lbs./ft. Wall thickness or gauge No. SPR-26

TYPE OF SCREEN OR PERFORATION MATERIAL:
 1 Steel 3 Stainless steel 5 Fiberglass 7 PVC 8 RMP (SR) 10 Asbestos-cement
 2 Brass 4 Galvanized steel 6 Concrete tile 9 ABS 11 Other (specify)
 12 None used (open hole)

SCREEN OR PERFORATION OPENINGS ARE:
 1 Continuous slot 3 Mill slot 5 Gauzed wrapped 8 Saw cut 11 None (open hole)
 2 Louvered shutter 4 Key punched 6 Wire wrapped 9 Drilled holes
 7 Torch cut 10 Other (specify)


6 GROUT MATERIAL:
 1 Neat cement 2 Cement grout 3 Bentonite 4 Other
 Grout intervals: From 3 ft. to 13 ft., From 13 ft. to 74 ft., From 13 ft. to 74 ft., From 13 ft. to 74 ft.

What is the nearest source of possible contamination:
 1 Septic tank 4 Lateral lines 7 Pit privy 10 Livestock pens 14 Abandoned water well
 2 Sewer lines 5 Cess pool 8 Sewage lagoon 11 Fuel storage 15 Oil well/Gas well
 3 Watertight sewer lines 6 Seepage pit 9 Feedyard 12 Fertilizer storage 16 Other (specify below)
 13 Insecticide storage

Direction from well? So. How many feet? 160

FROM	TO	LITHOLOGIC LOG	FROM	TO	LITHOLOGIC LOG
0	2	TOP SOIL			
2	106	CLAY			
10	19	FINE SAND			
19	74	CHARCOAL SHALE			

7 CONTRACTOR'S OR LANDOWNER'S CERTIFICATION: This water well was (1) constructed, (2) reconstructed, or (3) plugged under my jurisdiction and was completed on (mo/day/year) 5-15-87 and this record is true to the best of my knowledge and belief. Kansas Water Well Contractor's License No. 318 This Water Well Record was completed on (mo/day/yr) 5-20-87 under the business name of Weninger Drilling by (signature) Arnone W. Weninger