


1 LOCATION OF WATER WELL: County: Sedawick Fraction: NW 1/4 NE 1/4 SW 1/4 Section Number: 31 Township Number: T 25 S Range Number: R 1 E/W

Distance and direction from nearest town or city street address of well if located within city? 125 S. Emporia

2 WATER WELL OWNER: BOB GIEBLER RR#, St. Address, Box #: 125 S. Emporia City, State, ZIP Code: VALLEY CENTER, KS 67147

Board of Agriculture, Division of Water Resources Application Number:

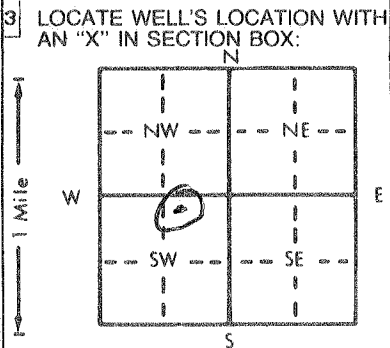

4 DEPTH OF COMPLETED WELL: 33 ft. ELEVATION: _____

Depth(s) Groundwater Encountered 1. N/A ft. 2. _____ ft. 3. _____ ft.

WELL'S STATIC WATER LEVEL 15 ft. below land surface measured on mo/day/yr 3-17-94

Pump test data: Well water was N/A ft. after _____ hours pumping _____ gpm

Est. Yield _____ gpm: Well water was _____ ft. after _____ hours pumping _____ gpm

Bore Hole Diameter 8 in. to 15 in. and _____ in. to _____ in.

WELL WATER TO BE USED AS:

5 Public water supply	8 Air conditioning	11 Injection well
1 Domestic	3 Feedlot	6 Oil field water supply
2 Irrigation	4 Industrial	7 <u>Lawn and garden only</u>
		9 Dewatering
		10 Monitoring well
		12 Other (Specify below)

Was a chemical/bacteriological sample submitted to Department? Yes _____ No X; If yes, mo/day/yr sample was submitted _____

Water Well Disinfected? Yes X No _____

5 TYPE OF BLANK CASING USED:

1 Steel	3 RMP (SR)	5 Wrought iron	8 Concrete tile	CASING JOINTS: Glued <u>X</u> Clamped _____
2 <u>PVC</u>	4 ABS	6 Asbestos-Cement	9 Other (specify below)	Welded _____
		7 Fiberglass		Threaded _____

Blank casing diameter 5 in. to 23 in. Dia. _____ in. to _____ in. Dia. _____ in. to _____ in.

Casing height above land surface 12 in., weight 200 lbs./ft. Wall thickness or gauge No. 14

TYPE OF SCREEN OR PERFORATION MATERIAL:

1 Steel	3 Stainless steel	5 Fiberglass	8 RMP (SR)	10 Asbestos-cement
2 Brass	4 Galvanized steel	6 Concrete tile	9 ABS	11 Other (specify)
				12 None used (open hole)

SCREEN OR PERFORATION OPENINGS ARE:

1 Continuous slot	3 <u>Mill slot</u>	5 Gauzed wrapped	8 Saw cut	11 None (open hole)
2 Louvered shutter	4 Key punched	6 Wire wrapped	9 Drilled holes	
		7 Torch cut	10 Other (specify)	

SCREEN-PERFORATED INTERVALS: From 23 ft. to 33 ft., From _____ ft. to _____ ft.

GRAVEL PACK INTERVALS: From N/A ft. to N/A ft., From _____ ft. to _____ ft.

6 GROUT MATERIAL: 1 Neat cement 2 Cement grout 3 Bentonite 4 Other _____

Grout intervals: From 3 ft. to 13 ft., From _____ ft. to _____ ft.

What is the nearest source of possible contamination:

1 Septic tank	4 Lateral lines	7 Pit privy	10 Livestock pens	14 Abandoned water well
2 Sewer lines	5 Cess pool	8 Sewage lagoon	11 Fuel storage	15 Oil well/Gas well
3 <u>Watertight sewer lines</u>	6 Seepage pit	9 Feedyard	12 Fertilizer storage	16 Other (specify below)
			13 Insecticide storage	

Direction from well? 5 How many feet? 12

FROM	TO	LITHOLOGIC LOG	FROM	TO	PLUGGING INTERVALS
0	3	TOP SOIL			
3	9	BRN SAND			
9	19	BRN & WHT SANDY GRAVEL			
19	33	MED SIZE PEAT GRAVEL			

7 CONTRACTOR'S OR LANDOWNER'S CERTIFICATION: This water well was (1) constructed, (2) reconstructed, or (3) plugged under my jurisdiction and was completed on (mo/day/year) 3-17-94 and this record is true to the best of my knowledge and belief. Kansas Water Well Contractor's License No. 313 This Water Well Record was completed on (mo/day/yr) 6-22-94 under the business name of JET DRILLING by (signature) [Signature]

INSTRUCTIONS: Use typewriter or ball point pen. PLEASE PRESS FIRMLY and PRINT clearly. Please fill in blanks, underline or circle the correct answers. Send top three copies to Kansas Department of Health and Environment, Bureau of Water, Topeka, Kansas 66620-0001. Telephone: 913-298-5545. Send one to WATER WELL OWNER and retain one for your records.