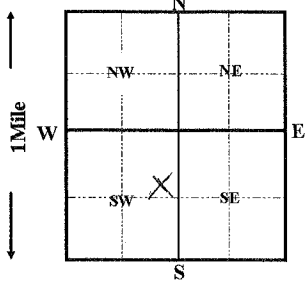


1 LOCATION OF WATER WELL: Sedgwick	FRACTION SE 1/4 NE 1/4 SW 1/4	Section Number 31	Township Number T 25 S	Range Number R 1E E/W
--	---	-----------------------------	----------------------------------	---------------------------------

Distance and direction from nearest town or city street address of well if located within city?
801 E. Allen Valley Center, Kansas

2 WATER WELL OWNER: WILBUR, Tony RR#, ST. ADDRESS, BOX #: 801 E. Allen CITY, STATE, ZIP CODE: Valley Center, Kansas	Board of Agriculture, Division of Water Resource Application Number:
--	---

3 LOCATE WELL'S LOCATION WITH AN "X" IN SECTION BOX: 	4 DEPTH OF COMPLETED WELL 35 ft. ELEVATION: Depth(s) groundwater Encountered 1 ft. 2 ft. 3 ft. WELL'S STATIC WATER LEVEL 12 FT. BELOW LAND SURFACE MEASURED ON 06/14/1993 Pump test data: Well water was _____ ft. after _____ hours pumping _____ gpm Est. Yield gpm: Well water was _____ ft. after _____ hours pumping _____ gpm Bore Hole Diameter 12 in. to 35 ft., and _____ in. to _____ ft. WELL WATER TO BE USED AS: 5 Public water supply 8 Air conditioning 11 Injection well 1 Domestic 3 Feedlot 6 Oil field water supply 9 Dewatering 12 Other (Specify below) 2 Irrigation 4 Industrial 7 Lawn and garden only 10 Monitoring well Was a chemical/bacteriological sample submitted to Department? Yes _____ No X ; If yes, mo/day/yr sample was submitted Water Well Disinfected? Yes X No _____
--	--

5 TYPE OF CASING USED: 1 Steel 3 RMP (SR) 2 PVC 4 ABS	5 Wrought iron 8 Concrete tile 6 Asbestos-Cement 9 Other (Specify below) 7 Fiberglass SDR-26	CASING JOINTS: X Glued X Clamped Welded Threaded
Blank casing Diameter 5 in. to 25 ft., Dia _____ in. to _____ ft. Casing height above land surface 16 in., weight 2.35 lbs. / ft. Wall thickness or gauge No. .214	TYPE OF SCREEN OR PERFORATION MATERIAL: 1 Steel 3 Stainless Steel 5 Fiberglass 8 RMP (SR) 10 Asbestos-cement 11 other (specify) 2 Brass 4 Galvanized steel 6 Concrete tile 9 ABS 12 None used (open hole)	
SCREEN OR PERFORATION OPENING ARE: 1 Continuous slot 3 Mill slot 5 Gauzed wrapped 8 Saw cut 11 None (open hole) 2 Louvered shutter 4 Key punched 6 Wire wrapped 9 Drilled holes 7 Torch cut 10 Other (specify)	SCREEN-PERFORATION INTERVALS: from 25 ft. to 35 ft., From _____ ft. to _____ ft. GRAVEL PACK INTERVALS: from 24 ft. to 35 ft., From _____ ft. to _____ ft.	

6 GROUT MATERIAL: 1 Neat cement 2 Cement grout 3 Bentonite 4 Other	Grout Intervals: From 4 ft. to 24 ft., From _____ ft. to _____ ft.	10 Livestock pens 14 Abandon water well 11 Fuel storage 15 Oil well/Gas well 12 Fertilizer storage 16 Other (specify below) 13 Insecticide storage None Apparent
What is the nearest source of possible contamination: 1 Septic tank 4 Lateral lines 7 Pit privy 2 Sewer lines 5 Cess pool 8 Sewage lagoon 3 Watertight sewer lines 6 Seepage pit 9 Feedyard	Direction from well? _____ How many feet? _____	

FROM	TO	LITHOLOGIC LOG	FROM	TO	PLUGGING INTERVALS
0	2	topsoil			
2	10	clay			
10	20	sandy clay			
20	35	medium to coarse sand			

7 CONTRACTOR'S OR LANDOWNER'S CERTIFICATION: This water well was (1) constructed, (2) reconstructed, or (3) plugged under my jurisdiction and was completed on (mo/day/year) 06/14/1993 and this record is true to the best of my knowledge and belief. Kansas Water Well Contractor's License No. 236 This Water Well Record was completed on (mo/day/yr) 06/28/93 Under the business name of Harp Well & Pump Service, Inc. by (signature) <i>Jane Frederick</i>
579