


1 LOCATION OF WATER WELL: County: Sedgewick Fraction: NW 1/4 NW 1/4 NW 1/4 Section Number: 31 Township Number: T 25 S Range Number: R 1 EW

Distance and direction from nearest town or city street address of well if located within city? In Valley Center; Burger Nut 556 N. Meridian

2 WATER WELL OWNER: Donna Dunn
 RR#, St. Address, Box #: 2809 Key West Ct.
 City, State, ZIP Code: Wichita Ks 67204
 Board of Agriculture, Division of Water Resources
 Application Number:

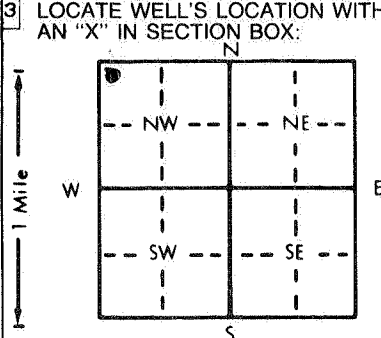

4 DEPTH OF COMPLETED WELL: 23' ft. ELEVATION: ft.
 Depth(s) Groundwater Encountered: 1. 14.5' ft. 2. ft. 3. ft.
 WELL'S STATIC WATER LEVEL: 13.1' ft. below land surface measured on mo/day/yr 11-18-93
 Pump test data: Well water was ft. after hours pumping gpm
 Est. Yield: gpm; Well water was ft. after hours pumping gpm
 Bore Hole Diameter: 7 1/2" in. to 23' ft., and in. to ft.
 WELL WATER TO BE USED AS:
 1 Domestic 3 Feedlot 6 Oil field water supply 9 Dewatering 12 Other (Specify below)
 2 Irrigation 4 Industrial 7 Lawn and garden only 10 Monitoring well
 Was a chemical/bacteriological sample submitted to Department? Yes..... No. X.....; If yes, mo/day/yr sample was submitted
 Water Well Disinfected? Yes No. X.....

5 TYPE OF BLANK CASING USED:
 1 Steel 3 RMP (SR) 5 Wrought iron 8 Concrete tile CASING JOINTS: Glued Clamped
2 PVC 4 ABS 6 Asbestos-Cement 9 Other (specify below) Welded
 7 Fiberglass Threaded. X
 Blank casing diameter 2.42 in. to 13' ft., Dia in. to ft., Dia in. to ft.
 Casing height above land surface Flush Mount in., weight lbs./ft. Wall thickness or gauge No. SOR-13
 TYPE OF SCREEN OR PERFORATION MATERIAL: 7 PVC 10 Asbestos-cement Sen 40
 1 Steel 3 Stainless steel 5 Fiberglass 8 RMP (SR) 11 Other (specify)
 2 Brass 4 Galvanized steel 6 Concrete tile 9 ABS 12 None used (open hole)
 SCREEN OR PERFORATION OPENINGS ARE:
 1 Continuous slot 3 Mill slot 5 Gauzed wrapped 8 Saw cut 11 None (open hole)
 2 Louvered shutter 4 Key punched 6 Wire wrapped 9 Drilled holes
 7 Torch cut 10 Other (specify)
 SCREEN-PERFORATED INTERVALS: From 23' ft. to 13' ft., From ft. to ft.
 From ft. to ft., From ft. to ft.
 GRAVEL PACK INTERVALS: From 23' ft. to 12' ft., From ft. to ft.
 From ft. to ft., From ft. to ft.

6 GROUT MATERIAL: 1 Neat cement 2 Cement grout 3 Bentonite 4 Other
 Grout Intervals: From 12' ft. to 3' ft., From 3' ft. to 0' ft., From ft. to ft.
 What is the nearest source of possible contamination:
 1 Septic tank 4 Lateral lines 7 Pit privy 10 Livestock pens 14 Abandoned water well
 2 Sewer lines 5 Cess pool 8 Sewage lagoon 11 Fuel storage Farmer 15 Oil well/Gas well
 3 Watertight sewer lines 6 Seepage pit 9 Feedyard 12 Fertilizer storage 16 Other (specify below)
 13 Insecticide storage
 Direction from well? North How many feet? 10'

FROM	TO	LITHOLOGIC LOG	FROM	TO	PLUGGING INTERVALS
0	1.50	Concrete			
1.50	3.0	DK Gray to Black silty clay, wood frag.			
3.0	5.2	olive green silty clay w/ yellow Brn. Mottling			
5.2	12.3	olive green to gray clayey silt w/ yellow Brn Mottling			
12.3	14.5	yellow brown sand.			
14.5	23.0	gray fine-coarse grained sand, DK Gray silty, len, well graded sand			

7 CONTRACTOR'S OR LANDOWNER'S CERTIFICATION: This water well was (1 constructed, (2) reconstructed, or (3) plugged under my jurisdiction and was completed on (mo/day/year) 11-18-93 and this record is true to the best of my knowledge and belief. Kansas Water Well Contractor's License No. 539 This Water Well Record was completed on (mo/day/yr) 11-21-93 under the business name of QB Environmental Drilling by (signature) James Beber

INSTRUCTIONS: Use typewriter or ball point pen. PLEASE PRESS FIRMLY and PRINT clearly. Please fill in blanks, underline or circle the correct answers. Send top three copies to Kansas Department of Health and Environment, Bureau of Water, Topeka, Kansas 66620-0001. Telephone: 913-296-5545. Send one to WATER WELL OWNER and retain one for your records.