


1 LOCATION OF WATER WELL: County: **SEDGWICK** Fraction **SE 1/4 SW 1/4 SW 1/4** Section Number **31** Township Number **T 25 S** Range Number **R 1E E/W**

Distance and direction from nearest town or city street address of well if located within city?  
**714 Clay Valley Center, Kansas**

2 WATER WELL OWNER: **George Northstead**  
 RR#, St. Address, Box # : **714 Clay** Board of Agriculture, Division of Water Resources  
 City, State, ZIP Code : **Valley Center, Kansas** Application Number:

3 LOCATE WELL'S LOCATION WITH AN "X" IN SECTION BOX: 4 DEPTH OF COMPLETED WELL... **25** ft. ELEVATION: .....

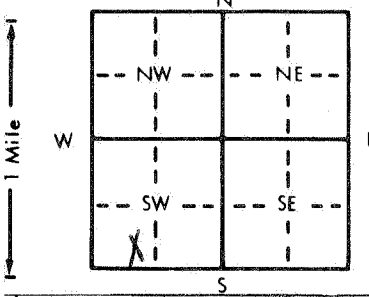

Depth(s) Groundwater Encountered 1. ... **15** ... ft. 2. ... ft. 3. ... ft.  
 WELL'S STATIC WATER LEVEL ... **15** ... ft. below land surface measured on mo/day/yr **8-1-85**  
 Pump test data: Well water was ... ft. after ... hours pumping ... gpm  
 Est. Yield ... gpm: Well water was ... ft. after ... hours pumping ... gpm  
 Bore Hole Diameter ... **11** ... in. to ... ft., and ... in. to ... ft.  
 WELL WATER TO BE USED AS: 5 Public water supply 8 Air conditioning 11 Injection well  
 1 Domestic 3 Feedlot 6 Oil field water supply 9 Dewatering 12 Other (Specify below)  
 2 Irrigation 4 Industrial 7 Lawn and garden only 10 Observation well  
 Was a chemical/bacteriological sample submitted to Department? Yes.....No... **XX**...; If yes, mo/day/yr sample was submitted  
 Water Well Disinfected? Yes **XX** No

5 TYPE OF BLANK CASING USED: 5 Wrought iron 8 Concrete tile CASING JOINTS: Glued .. **XX** Clamped ..  
 1 Steel 3 RMP (SR) 6 Asbestos-Cement 9 Other (specify below) Welded ..  
 2 PVC 4 **ABS** 7 Fiberglass **Cer-Mac styrene SDR-26** Threaded ..  
 Blank casing diameter ... **5** in. to ... **15** ft., Dia ... in. to ... ft., Dia ... in. to ... ft.  
 Casing height above land surface ... **12** in., weight ... **1.59** lbs./ft. Wall thickness or gauge No. ... **203**

TYPE OF SCREEN OR PERFORATION MATERIAL: 7 PVC 10 Asbestos-cement  
 1 Steel 3 Stainless steel 5 Fiberglass 8 RMP (SR) 11 Other (specify) ..  
 2 Brass 4 Galvanized steel 6 Concrete tile **9 ABS** 12 None used (open hole)

SCREEN OR PERFORATION OPENINGS ARE: 5 Gauzed wrapped 8 Saw cut 11 None (open hole)  
 1 Continuous slot 3 Mill slot 6 Wire wrapped **9 Drilled holes**  
 2 Louvered shutter 4 Key punched 7 Torch cut 10 Other (specify) ..

SCREEN-PERFORATED INTERVALS: From ... **15** ft. to ... **25** ft., From ... ft. to ... ft.  
 GRAVEL PACK INTERVALS: From ... **14** ft. to ... **25** ft., From ... ft. to ... ft.

3 GROUT MATERIAL: 1 Neat cement 2 Cement grout 3 Bentonite 4 Other ..  
 Grout Intervals: From ... **4** ft. to ... **14** ft., From ... ft. to ... ft., From ... ft. to ... ft.

What is the nearest source of possible contamination: 10 Livestock pens 14 Abandoned water well  
 1 Septic tank 4 Lateral lines 7 Pit privy 11 Fuel storage 15 Oil well/Gas well  
 2 Sewer lines 5 Cess pool 8 Sewage lagoon 12 Fertilizer storage 16 Other (specify below)  
 3 Watertight sewer lines 6 Seepage pit 9 Feedyard 13 Insecticide storage  
 Direction from well? **North** How many feet? **65**

FROM	TO	LITHOLOGIC LOG	FROM	TO	LITHOLOGIC LOG
0	3	Topsoil			
3	9	Clay			
9	17	Fine Sand			
17	25	Medium Sand			

7 CONTRACTOR'S OR LANDOWNER'S CERTIFICATION: This water well was (1) constructed, (2) reconstructed, or (3) plugged under my jurisdiction and was completed on (mo/day/year) ... **8-1-85** ... and this record is true to the best of my knowledge and belief. Kansas Water Well Contractor's License No. ... **236** ... This Water Well Record was completed on (mo/day/yr) ... **11-2-85** ... under the business name of **Harp Well & Pump Service, Inc.** by (signature) *Mary Arnold*  
 INSTRUCTIONS: Use typewriter or ball point pen, **PLEASE PRESS FIRMLY** and **PRINT** clearly. Please fill in blanks, underline or circle the correct answers. Send top three copies to Kansas Department of Health and Environment, Division of Environment, Environmental Geology Section, Topeka, KS 66620. Send one to WATER WELL OWNER and retain one for your records.