


LOCATION OF WATER WELL: Fraction NE 1/4 NE 1/4 SW 1/4 Section Number 31 Township Number T 25 S Range Number R 1 E/W
 County: SEDGWICK

Distance and direction from nearest town or city street address of well if located within city?
120 MILES VALLEY CENTER, KANS

WATER WELL OWNER: GEORGE WHITE Board of Agriculture, Division of Water Resources
 RR#, St. Address, Box #: 120 MILES VALLEY CENTER, KANS Application Number: NONE
 City, State, ZIP Code: 120 MILES VALLEY CENTER, KANS

LOCATE WELL'S LOCATION WITH AN "X" IN SECTION BOX:

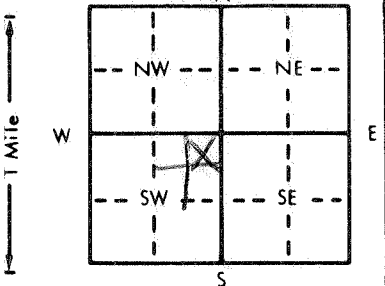

DEPTH OF COMPLETED WELL: 268 ft. ELEVATION: 1300 ft.

Depth(s) Groundwater Encountered 1. 8 ft. 2. BASEMENT ft. 3. 4-4-86 ft.
 WELL'S STATIC WATER LEVEL 8 ft. below land surface measured on mo/day/yr 4-4-86
 Pump test data: Well water was NA ft. after NA hours pumping NA gpm
 Est. Yield 50 gpm Well water was NA ft. after NA hours pumping NA gpm
 Bore Hole Diameter 9 in. to 8 ft., and 6 in. to 26 ft.

WELL WATER TO BE USED AS:
 1 Domestic 2 Irrigation 3 Feedlot 4 Industrial 5 Public water supply 6 Oil field water supply 7 Lawn and garden only 8 Air conditioning 9 Dewatering 10 Observation well 11 Injection well 12 Other (Specify below)
 Was a chemical/bacteriological sample submitted to Department? Yes No If yes, mo/day/yr sample was submitted NA
 Water Well Disinfected? Yes No

TYPE OF BLANK CASING USED:
 1 Steel 3 RMP (SR) 5 Wrought iron 6 Asbestos-Cement 7 Fiberglass 8 Concrete tile 9 Other (specify below) CASING JOINTS Glued Clamped Welded Threaded
 2 PVC 4 ABS

Blank casing diameter 5 in. to 19 ft., Dia. 1.59 lbs./ft. Wall thickness or gauge No. SDR21

TYPE OF SCREEN OR PERFORATION MATERIAL:
 1 Steel 2 Brass 3 Stainless steel 4 Galvanized steel 5 Fiberglass 6 Concrete tile 8 RMP (SR) 7 PVC 9 ABS 10 Asbestos-cement 11 Other (specify) 12 None used (open hole)

SCREEN OR PERFORATION OPENINGS ARE:
 1 Continuous slot 3 Mill slot 4 Key punched 5 Gauzed wrapped 6 Wire wrapped 7 Torch cut 8 Saw cut 9 Drilled holes 10 Other (specify) 11 None (open hole)

SCREEN-PERFORATED INTERVALS: From 18 ft. to 26 ft.
 GRAVEL PACK INTERVALS: From NONE ft. to NONE ft.

GROUT MATERIAL: 1 Neat cement 2 Cement grout 3 Bentonite 4 Other
 Grout Intervals: From 0 ft. to 8 ft.

What is the nearest source of possible contamination:
 1 Septic tank 2 Sewer lines 3 Watertight sewer lines 4 Lateral lines 5 Cess pool 6 Seepage pit 7 Pit privy 8 Sewage lagoon 9 Feedyard 10 Livestock pens 11 Fuel storage 12 Fertilizer storage 13 Insecticide storage 14 Abandoned water well 15 Oil well/Gas well 16 Other (specify below)

Direction from well? SOUTH How many feet? 11 FT.

| FROM | TO | LITHOLOGIC LOG | FROM | TO | LITHOLOGIC LOG |
|-----------|-----------|------------------------|------|----|----------------|
| <u>0</u> | <u>4</u> | <u>FINE SAND - TAN</u> | | | |
| <u>4</u> | <u>12</u> | <u>SAND MED TAN</u> | | | |
| <u>12</u> | <u>26</u> | <u>SAND COARSE TAN</u> | | | |

CONTRACTOR'S OR LANDOWNER'S CERTIFICATION: This water well was (1) constructed, (2) reconstructed, or (3) plugged under my jurisdiction and was completed on (mo/day/year) 4-4-86 and this record is true to the best of my knowledge and belief. Kansas Water Well Contractor's License No. 104 This Water Well Record was completed on (mo/day/yr) 5/21/86 under the business name of BEARDEN PUMPELL by (signature) [Signature]

INSTRUCTIONS: Use typewriter or ball point pen, PLEASE PRESS FIRMLY and PRINT clearly. Please fill in blanks, underline or circle the correct answers. Send top three copies to Kansas Department of Health and Environment, Division of Environment, Environmental Geology Section, Topeka, KS 66620. Send one to WATER WELL OWNER and retain one for your records.