


Tugging Report

1 LOCATION OF WATER WELL: County: *Bedford* Fraction: *SW 1/4 NW 1/4 SW 1/4* Section Number: *31* Township Number: *T 25 S* Range Number: *R 1 E/W*

Distance and direction from nearest town or city street address of well if located within city? *217 miles*

2 WATER WELL OWNER: *Phil Giam* RR#, St. Address, Box #: *317 miles* City, State, ZIP Code: *Vally Center Kan 67147* Board of Agriculture, Division of Water Resources Application Number:

3 LOCATE WELL'S LOCATION WITH AN "X" IN SECTION BOX: 4 DEPTH OF COMPLETED WELL: *25* ft. ELEVATION: *1300*

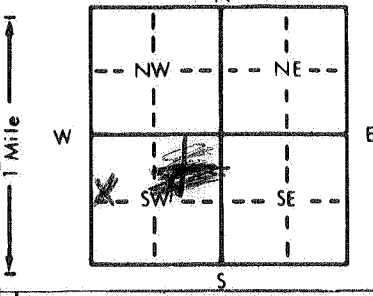

Depth(s) Groundwater Encountered 1. *12* ft. 2. ft. 3. ft.
 WELL'S STATIC WATER LEVEL *12* ft. below land surface measured on mo/day/yr *5-3-88*
 Pump test data: Well water was ft. after hours pumping gpm
 Est. Yield gpm: Well water was ft. after hours pumping gpm
 Bore Hole Diameter in. to ft., and in. to ft.
 WELL WATER TO BE USED AS: 5 Public water supply 8 Air conditioning 11 Injection well
 1 Domestic *Was* 3 Feedlot 6 Oil field water supply 9 Dewatering 12 Other (Specify below)
 2 Irrigation 4 Industrial 7 Lawn and garden only 10 Observation well
 Was a chemical/bacteriological sample submitted to Department? Yes.....No *X*.....; If yes, mo/day/yr sample was submitted
 Water Well Disinfected? Yes No *X*

5 TYPE OF BLANK CASING USED: 5 Wrought iron 8 Concrete tile CASING JOINTS: Glued Clamped
1 Steel 3 RMP (SR) 6 Asbestos-Cement 9 Other (specify below) Welded
 2 PVC 4 ABS 7 Fiberglass Threaded *X*

Blank casing diameter in. to ft., Dia in. to ft., Dia in. to ft.
 Casing height above land surface in., weight lbs./ft. Wall thickness or gauge No.

TYPE OF SCREEN OR PERFORATION MATERIAL: 7 PVC 10 Asbestos-cement
 1 Steel 3 Stainless steel 5 Fiberglass 8 RMP (SR) 11 Other (specify)
 2 Brass 4 Galvanized steel 6 Concrete tile 9 ABS 12 None used (open hole)

SCREEN OR PERFORATION OPENINGS ARE: 5 Gauzed wrapped 8 Saw cut 11 None (open hole)
 1 Continuous slot 3 Mill slot 6 Wire wrapped 9 Drilled holes
 2 Louvered shutter 4 Key punched 7 Torch cut 10 Other (specify)

SCREEN-PERFORATED INTERVALS: From ft. to ft., From ft. to ft., From ft. to ft.
 GRAVEL PACK INTERVALS: From ft. to ft., From ft. to ft., From ft. to ft.

6 GROUT MATERIAL: 1 Neat cement 2 Cement grout 3 Bentonite 4 Other
 Grout Intervals: From *0* ft. to *12* ft., From ft. to ft., From ft. to ft.

What is the nearest source of possible contamination:
 1 Septic tank 4 Lateral lines 7 Pit privy 10 Livestock pens 14 Abandoned water well
 2 Sewer lines 5 Cess pool 8 Sewage lagoon 11 Fuel storage 15 Oil well/Gas well
3 Watertight sewer lines 6 Seepage pit 9 Feedyard 12 Fertilizer storage 16 Other (specify below)
 13 Insecticide storage
 Direction from well? *North, East* How many feet? *35'*

FROM	TO	LITHOLOGIC LOG	FROM	TO	LITHOLOGIC LOG
		<i>Pulled & Plugged 1 1/4" Driven Sand Point Well in Basement</i>			
<i>0</i>	<i>12'</i>	<i>Cement grout flush with Basement floor</i>			

7 CONTRACTOR'S OR LANDOWNER'S CERTIFICATION: This water well was (1) constructed, (2) reconstructed, or (3) plugged under my jurisdiction and was completed on (mo/day/year) *5-3-88* and this record is true to the best of my knowledge and belief. Kansas Water Well Contractor's License No. *472* This Water Well Record was completed on (mo/day/yr) *5-3-88* under the business name of *Beardon Pump & Well Ser.* by (signature) *David R Beech*