


MW-1 2011054

1 LOCATION OF WATER WELL: Fraction NW 1/4 NW 1/4 SW 1/4 Section Number 31 Township Number T 25 S Range Number R 1 EW
 County: Sedgwick
 Distance and direction from nearest town or city street address of well if located within city?
142 S. Meridian

2 WATER WELL OWNER: Robert Tormey
 RR#, St. Address, Box #: 142 S. Meridian
 City, State, ZIP Code: Valley Center KS 67147
 Board of Agriculture, Division of Water Resources Application Number:

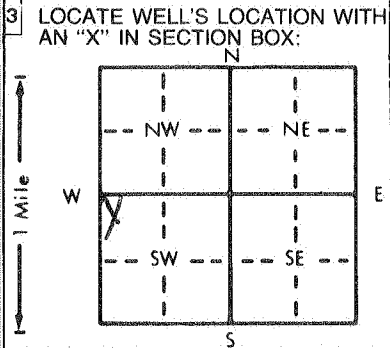

4 DEPTH OF COMPLETED WELL: 20 ft. ELEVATION: ft.
 Depth(s) Groundwater Encountered: 1. 14.6 ft. 2. ft. 3. ft.
 WELL'S STATIC WATER LEVEL: 14.62 ft. below land surface measured on mo/day/yr 3-11-93
 Pump test data: Well water was ft. after hours pumping gpm
 Est. Yield gpm; Well water was ft. after hours pumping gpm
 Bore Hole Diameter: 8 in. to ft., and in. to ft.
 WELL WATER TO BE USED AS:
 1 Domestic 3 Feedlot 6 Oil field water supply 9 Dewatering 12 Other (Specify below)
 2 Irrigation 4 Industrial 7 Lawn and garden only 10 Monitoring well
 Was a chemical/bacteriological sample submitted to Department? Yes.....No X.....; If yes, mo/day/yr sample was submitted
 Water Well Disinfected? Yes No X

5 TYPE OF BLANK CASING USED:
 1 Steel 3 RMP (SR) 5 Wrought iron 8 Concrete tile CASING JOINTS: Glued Clamped
2 PVC 4 ABS 7 Fiberglass Threaded Flush
 Blank casing diameter: 2 in. to ft., Dia. in. to ft., Dia. in. to ft.
 Casing height above land surface: Flush in., weight: 703 lbs./ft. Wall thickness or gauge No. 154
 TYPE OF SCREEN OR PERFORATION MATERIAL:
 1 Steel 3 Stainless steel 5 Fiberglass 8 RMP (SR) 10 Asbestos-cement
 2 Brass 4 Galvanized steel 6 Concrete tile 9 ABS 12 None used (open hole)
 SCREEN OR PERFORATION OPENINGS ARE:
 1 Continuous slot 3 Mill slot 5 Gauzed wrapped 8 Saw cut 11 None (open hole)
 2 Louvered shutter 4 Key punched 6 Wire wrapped 9 Drilled holes
 7 Torch cut 10 Other (specify)
 SCREEN-PERFORATED INTERVALS: From 10 ft. to 20 ft., From ft. to ft.
 GRAVEL PACK INTERVALS: From 9 ft. to 20 ft., From ft. to ft.

6 GROUT MATERIAL: 1 Neat cement 2 Cement grout 3 Bentonite 4 Other
 Grout intervals: From 9 ft. to ft., From ft. to ft., From ft. to ft.
 What is the nearest source of possible contamination:
 1 Septic tank 4 Lateral lines 7 Pit privy 11 Fuel storage 14 Abandoned water well
 2 Sewer lines 5 Cess pool 8 Sewage lagoon 12 Fertilizer storage 15 Oil well/Gas well
 3 Watertight sewer lines 6 Seepage pit 9 Feedyard 13 Insecticide storage 16 Other (specify below)
 Direction from well? SE How many feet? 110

FROM	TO	LITHOLOGIC LOG	FROM	TO	PLUGGING INTERVALS
0.0	8.5	Clayey sand			
8.5	13.5	Sand, clayey, very fine to med grain			
13.5	20.0	Sand, med to coarse grain			
<p>Flush mount waiver granted 12-10-92 for Tormey Service; KDHE 02087858 by Don Taylor</p>					

7 CONTRACTOR'S OR LANDOWNER'S CERTIFICATION: This water well was (1) constructed, (2) reconstructed, or (3) plugged under my jurisdiction and was completed on (mo/day/year) 3-11-93 and this record is true to the best of my knowledge and belief. Kansas Water Well Contractor's License No. 531 This Water Well Record was completed on (mo/day/yr) 3-25-93 under the business name of GST by (signature) Allison Irwin