


1 LOCATION OF WATER WELL: <b>Sedgwick</b>	FRACTION <b>SW 1/4 SE 1/4 NW 1/4</b>	Section Number <b>31</b>	Township Number <b>T 25 S</b>	Range Number <b>R 1E E/W</b>
--	---	-----------------------------	----------------------------------	---------------------------------

Distance and direction from nearest town or city street address of well if located within city?  
**129 N. Emporia Valley Center, Kansas**

2 WATER WELL OWNER: <b>SMITH, R.L. Construction</b> RR#, ST. ADDRESS, BOX #: <b>129 N. Emporia</b> CITY, STATE, ZIP CODE: <b>Valley Center, Kansas 67149</b>	Board of Agriculture, Division of Water Resource Application Number: _____
--	---

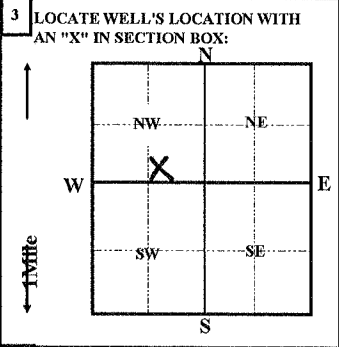

4 DEPTH OF COMPLETED WELL <b>40</b> ft. ELEVATION: Depth(s) groundwater Encountered 1 ft. 2 ft. 3 ft.	WELL'S STATIC WATER LEVEL <b>15</b> FT. BELOW LAND SURFACE MEASURED ON <b>03/23/1993</b> mo/day/yr
Pump test data: Well water was _____ ft. after _____ hours pumping _____ gpm	
Est. Yield gpm: Well water was _____ ft. after _____ hours pumping _____ gpm	
Bore Hole Diameter <b>12</b> in. to <b>40</b> ft., and _____ in. to _____ ft.	
WELL WATER TO BE USED AS: 5 Public water supply 8 Air conditioning 11 Injection well 1 Domestic 3 Feedlot 6 Oil field water supply 9 Dewatering 12 Other (Specify below)	
2 Irrigation 4 Industrial 7 Lawn and garden only 10 Monitoring well	
Was a chemical/bacteriological sample submitted to Department? Yes _____ No <b>X</b> ; If yes, mo/day/yr sample was submitted _____	
Water Well Disinfected? Yes <b>X</b> No _____	

5 TYPE OF CASING USED: 1 Steel 3 RMP (SR) 2 PVC 4 ABS	5 Wrought iron 8 Concrete tile 6 Asbestos-Cement 9 Other (Specify below) 7 Fiberglass <b>SDR-26</b>	CASING JOINTS: Glued <b>X</b> Clamped Welded Threaded
Blank casing Diameter <b>5</b> in. to <b>30</b> ft., Dia _____ in. to _____ ft., Dia _____ in. to _____ ft.		
Casing height above land surface <b>12</b> in., weight <b>2.35</b> lbs. / ft. Wall thickness or gauge No. <b>.214</b>		
TYPE OF SCREEN OR PERFORATION MATERIAL: 1 Steel 3 Stainless Steel 5 Fiberglass 8 RMP (SR) 10 Asbestos-cement 11 other (specify) 2 Brass 4 Galvanized steel 6 Concrete tile 9 ABS 12 None used (open hole)		
SCREEN OR PERFORATION OPENING ARE: 1 Continuous slot 3 Mill slot 5 Gauzed wrapped 8 Saw cut 11 None (open hole) 2 Louvered shutter 4 Key punched 6 Wire wrapped 9 Drilled holes 7 Torch cut 10 Other (specify)		
SCREEN-PERFORATION INTERVALS: from <b>30</b> ft. to <b>40</b> ft., From _____ ft. to _____ ft.		
GRAVEL PACK INTERVALS: from <b>24</b> ft. to <b>40</b> ft., From _____ ft. to _____ ft.		

6 GROUT MATERIAL: 1 Neat cement Grout Intervals: From <b>4</b> ft. to <b>24</b> ft., From _____ ft. to _____ ft.	2 Cement grout 3 Bentonite 4 Other	10 Livestock pens 14 Abandon water well 11 Fuel storage 15 Oil well/Gas well 12 Fertilizer storage 16 Other (specify below) 13 Insecticide storage <b>None Apparent</b>
What is the nearest source of possible contamination: 1 Septic tank 4 Lateral lines 7 Pit privy 2 Sewer lines 5 Cess pool 8 Sewage lagoon 3 Watertight sewer lines 6 Seepage pit 9 Feedyard		
Direction from well? _____ How many feet? _____		

FROM	TO	LITHOLOGIC LOG	FROM	TO	PLUGGING INTERVALS
0	3	topsoil			
3	14	clay			
14	26	fine sand			
26	40	medium sand			
					<b>SEPTIC SYSTEM NOT INSTALLED AT THIS TIME</b>

7 CONTRACTOR'S OR LANDOWNER'S CERTIFICATION: This water well was (1) <u>constructed</u> , (2) reconstructed, or (3) plugged under my jurisdiction and was completed on (mo/day/year) <b>03/23/1993</b> and this record is true to the best of my knowledge and belief. Kansas Water Well Contractor's License No. <b>236</b> This Water Well Record was completed on (mo/day/yr) <b>04/12/93</b> Under the business name of <b>Harp Well &amp; Pump Service, Inc</b> by (signature) <i>Jane Grederick</i>	356
--	-----