


1 LOCATION OF WATER WELL: Sedgwick	FRACTION NE 1/4 SE 1/4 SW 1/4	Section Number 31	Township Number T 25 S	Range Number R 1E E/W
--	---	-----------------------------	----------------------------------	---------------------------------

Distance and direction from nearest town or city street address of well if located within city?

700 Dover Drive Valley Center, Kansas

2 WATER WELL OWNER: MORRISON, Robert RR#, ST. ADDRESS, BOX #: 700 Dover Drive CITY, STATE, ZIP CODE: Valley Center, Kansas 67147	Board of Agriculture, Division of Water Resource Application Number:
---	---

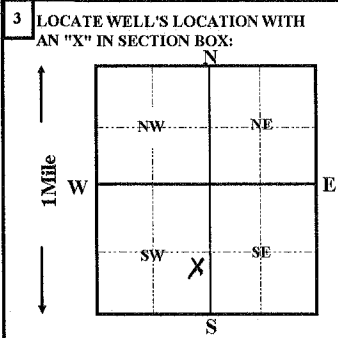

4 DEPTH OF COMPLETED WELL 26 ft. ELEVATION:	PLUGGED
Depth(s) groundwater Encountered 1 ft. 2 ft. 3 ft.	
WELL'S STATIC WATER LEVEL 14 FT. BELOW LAND SURFACE MEASURED ON 06/14/1993	
Pump test data: Well water was _____ ft. after _____ hours pumping _____ gpm	
Est. Yield _____ gpm: Well water was _____ ft. after _____ hours pumping _____ gpm	
Bore Hole Diameter _____ in. to _____ ft., and _____ in. to _____ ft.	
WELL WATER TO BE USED AS: 5 Public water supply 8 Air conditioning 11 Injection well	
1 Domestic 3 Feedlot 6 Oil field water supply 9 Dewatering 12 Other (Specify below)	
2 Irrigation 4 Industrial 7 Lawn and garden only 10 Monitoring well	
Was a chemical/bacteriological sample submitted to Department? Yes _____ No X ; If yes, mo/day/yr sample was submitted _____	Water Well Disinfected? Yes X No _____

5 TYPE OF CASING USED:	5 Wrought iron	8 Concrete tile	CASING JOINTS:	Glued	Clamped
1 Steel	3 RMP (SR)	6 Asbestos-Cement	9 Other (Specify below)	Welded	
2 PVC	4 ABS	7 Fiberglass		Threaded	
Blank casing Diameter 1 1/4 in. to _____ ft., Dia _____ in. to _____ ft., Dia _____ in. to _____ ft.					
Casing height above-land surface 60 in., weight _____ lbs. / ft.				Wall thickness or gauge No.	
TYPE OF SCREEN OR PERFORATION MATERIAL:	5 Fiberglass	8 RMP (SR)	10 Asbestos-cement	11 other (specify)	
1 Steel	3 Stainless Steel	6 Concrete tile	9 ABS	12 None used (open hole)	
2 Brass	4 Galvanized steel				
SCREEN OR PERFORATION OPENING ARE:	5 Gauzed wrapped	8 Saw cut	11 None (open hole)		
1 Continuous slot	3 Mill slot	6 Wire wrapped	9 Drilled holes		
2 Louvered shutter	4 Key punched	7 Torch cut	10 Other (specify)		
SCREEN-PERFORATION INTERVALS: from _____ ft. to _____ ft., From _____ ft. to _____ ft.					
GRAVEL PACK INTERVALS: from _____ ft. to _____ ft., From _____ ft. to _____ ft.					

6 GROUT MATERIAL: 1 Neat cement	2 Cement grout	3 Bentonite	4 Other
Grout Intervals: From 0 ft. to 10 ft., From _____ ft. to _____ ft.			
What is the nearest source of possible contamination:	10 Livestock pens	14 Abandon water well	
1 Septic tank	4 Lateral lines	7 Pit privy	11 Fuel storage
2 Sewer lines	5 Cess pool	8 Sewage lagoon	12 Fertilizer storage
3 Watertight sewer lines	6 Seepage pit	9 Feedyard	13 Insecticide storage
			None Apparent
Direction from well? _____	How many feet? _____		

FROM	TO	LITHOLOGIC LOG	FROM	TO	PLUGGING INTERVALS
			0	10	cement grout
			10	13	bentonite hole plug
			13	26	chlorinated sand and gravel

7 CONTRACTOR'S OR LANDOWNER'S CERTIFICATION: This water well was (1) constructed, (2) reconstructed, or (3) plugged under my jurisdiction and was completed on (mo/day/year) 06/14/1993 and this record is true to the best of my knowledge and belief. Kansas Water Well Contractor's License No. 236 . This Water Well Record was completed on (mo/day/yr) 06/16/93 . Under the business name of Harp Well & Pump Service, Inc. by (signature) <i>Jane Frederick</i>
--