


1 LOCATION OF WATER WELL: County: Sedgewick Fraction SE 1/4 NE 1/4 SE 1/4 Section Number 36 Township Number T 25 S Range Number R 1 W

Distance and direction from nearest town or city street address of well if located within city? 420 Clay

2 WATER WELL OWNER: Mrs Soice RR#, St. Address, Box #: 420 Clay Valley Center 67147 Board of Agriculture, Division of Water Resources Application Number: None

3 LOCATE WELL'S LOCATION WITH AN "X" IN SECTION BOX:

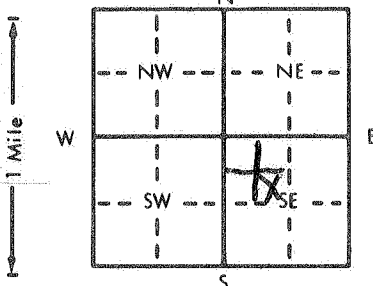

4 DEPTH OF COMPLETED WELL: 36 ft. ELEVATION: 1300

Depth(s) Groundwater Encountered: 16 ft. WELL'S STATIC WATER LEVEL: 16 ft. below land surface measured on 1-10-89. Pump test data: Well water was 9 gpm after 16 hours pumping. Est. Yield: 9 gpm. Bore Hole Diameter: 9 in. to 16 in. WELL WATER TO BE USED AS: 5 Public water supply, 8 Air conditioning, 11 Injection well, 12 Other (Specify below).

5 TYPE OF CASING USED: 1 Steel, 2 PVC, 3 RMP (SR), 4 ABS, 5 Wrought iron, 6 Asbestos-Cement, 7 Fiberglass, 8 Concrete tile, 9 Other (specify below), 10 Asbestos-cement, 11 Other (specify), 12 None used (open hole).

Blank casing diameter: 5.56 in. to 26 in. Dia. Casing height above land surface: 12 in., weight lbs./ft. Wall thickness or gauge No. CASING JOINTS: Glued X, Clamped X, Welded, Threaded.

TYPE OF SCREEN OR PERFORATION MATERIAL: 1 Steel, 2 Brass, 3 Stainless steel, 4 Galvanized steel, 5 Fiberglass, 6 Concrete tile, 7 PVC, 8 RMP (SR), 9 ABS, 10 Asbestos-cement, 11 Other (specify), 12 None used (open hole).

SCREEN OR PERFORATION OPENINGS ARE: 1 Continuous slot, 2 Louvered shutter, 3 Mill slot, 4 Key punched, 5 Gauzed wrapped, 6 Wire wrapped, 7 Torch cut, 8 Saw cut, 9 Drilled holes, 10 Other (specify), 11 None (open hole).

SCREEN-PERFORATED INTERVALS: From 26 ft. to 36 ft. GRAVEL PACK INTERVALS: None

6 GROUT MATERIAL: 1 Neat cement, 2 Cement grout, 3 Bentonite, 4 Other. Grout intervals: From 0 ft. to 16 ft.

What is the nearest source of possible contamination: 1 Septic tank, 2 Sewer lines, 3 Watertight sewer lines, 4 Lateral lines, 5 Cess pool, 6 Seepage pit, 7 Pit privy, 8 Sewage lagoon, 9 Feedyard, 10 Livestock pens, 11 Fuel storage, 12 Fertilizer storage, 13 Insecticide storage, 14 Abandoned water well, 15 Oil well/Gas well, 16 Other (specify below).

Direction from well? SE How many feet? 50

Table with columns: FROM, TO, LITHOLOGIC LOG, FROM, TO, PLUGGING INTERVALS. Rows include: 0-8 Top Soil, 8-16 Fine Tan sand, 16-30 coarse Tan sand.

7 CONTRACTOR'S OR LANDOWNER'S CERTIFICATION: This water well was (1) constructed, (2) reconstructed, or (3) plugged under my jurisdiction and was completed on (mo/day/year) 1-10-89 and this record is true to the best of my knowledge and belief. Kansas Water Well Contractor's License No. 472 This Water Well Record was completed on (mo/day/yr) 1-11-89 under the business name of Beardon Pump & Well Ser. by (signature) David R. Beech