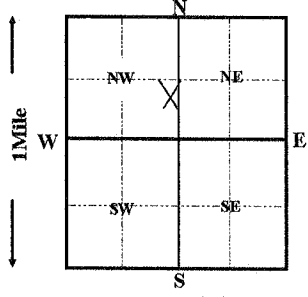


1 LOCATION OF WATER WELL:	FRACTION	Section Number	Township Number	Range Number
Sedgwick	NE 1/4 SE 1/4 NW 1/4	31	T 25 S	R 1E E/W

Distance and direction from nearest town or city street address of well if located within city?

214 N. Miles Valley Center, Kansas

2 WATER WELL OWNER: HARRIMAN, Keith RR#, ST. ADDRESS, BOX #: 214 N. Miles CITY, STATE, ZIP CODE: Valley Center, Kansas	Board of Agriculture, Division of Water Resource Application Number:
--	---

3 LOCATE WELL'S LOCATION WITH AN "X" IN SECTION BOX: 	4 DEPTH OF COMPLETED WELL 30 ft. ELEVATION: Depth(s) groundwater Encountered 1 ft. 2 ft. 3 ft. WELL'S STATIC WATER LEVEL 15 FT. BELOW LAND SURFACE MEASURED ON mo/day/yr 03/20/1995 Pump test data: Well water was ft. after hours pumping gpm Est. Yield gpm: Well water was ft. after hours pumping gpm Bore Hole Diameter 12 in. to 30 ft. and in. to ft. WELL WATER TO BE USED AS: 5 Public water supply 8 Air conditioning 11 Injection well 1 Domestic 3 Feedlot 6 Oil field water supply 9 Dewatering 12 Other (Specify below) 2 Irrigation 4 Industrial 7 Lawn and garden only 10 Monitoring well Was a chemical/bacteriological sample submitted to Department? Yes No X ; If yes, mo/day/yr sample was submitted Water Well Disinfected? Yes X No
---	---

5 TYPE OF CASING USED: 1 Steel 3 RMP (SR) 2 PVC 4 ABS Blank casing Diameter 5 in. to 20 ft., Dia in. to ft., Dia in. to ft. Casing height above land surface 12 in., weight 2.35 lbs. / ft. Wall thickness or gauge No. .214	5 Wrought iron 8 Concrete tile 6 Asbestos-Cement 9 Other (Specify below) 7 Fiberglass SDR-26	CASING JOINTS: Glued X Clamped Welded Threaded
TYPE OF SCREEN OR PERFORATION MATERIAL: 1 Steel 3 Stainless Steel 2 Brass 4 Galvanized steel	5 Fiberglass 6 Concrete tile	7 PVC 10 Asbestos-cement 8 RMP (SR) 11 other (specify) 9 ABS 12 None used (open hole)
SCREEN OR PERFORATION OPENING ARE: 1 Continuous slot 3 Mill slot 2 Louvered shutter 4 Key punched	5 Gauzed wrapped 6 Wire wrapped 7 Torch cut	8 Saw cut 11 None (open hole) 9 Drilled holes 10 Other (specify)
SCREEN-PERFORATION INTERVALS: from 20 ft. to 25 ft., From ft. to ft.		
GRAVEL PACK INTERVALS: from 20 ft. to 30 ft., From ft. to ft.		

6 GROUT MATERIAL: 1 Neat cement Grout Intervals: From 0 ft. to 20 ft. From ft. From ft. From ft. to ft.	2 Cement grout 3 Bentonite 4 Other	10 Livestock pens 11 Fuel storage 12 Fertilizer storage 13 Insecticide storage 14 Abandon water well 15 Oil well/Gas well 16 Other (specify below)
What is the nearest source of possible contamination: 1 Septic tank 4 Lateral lines 2 Sewer lines 5 Cess pool 3 Watertight sewer lines 6 Seepage pit	7 Pit privy 8 Sewage lagoon 9 Feedyard	

Direction from well? East		How many feet? 15	
FROM	TO	LITHOLOGIC LOG	PLUGGING INTERVALS
0	4	topsoil	
4	15	clay	
15	30	medium sand	

7 CONTRACTOR'S OR LANDOWNER'S CERTIFICATION: This water well was (1) constructed, (2) reconstructed, or (3) plugged under my jurisdiction and was completed on (mo/day/year) 03/20/1995 and this record is true to the best of my knowledge and belief. Kansas Water Well Contractor's License No. 236 . This Water Well Record was completed on (mo/day/yr) 04/06/95 . Under the business name of Harp Well & Pump Service, Inc by (signature)	<i>Jane Frederick</i>
---	-----------------------