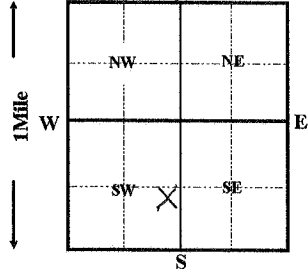


1 LOCATION OF WATER WELL: Sedgwick	FRACTION NE 1/4 SE 1/4 SW 1/4	Section Number 31	Township Number T 25 S	Range Number R 1E EW
--	---	-----------------------------	----------------------------------	--------------------------------

Distance and direction from nearest town or city street address of well if located within city?
839 Butler Valley Center, Kansas

2 WATER WELL OWNER: MC COMAS, Ron RR#, ST. ADDRESS, BOX #: 839 Butler CITY, STATE, ZIP CODE: Valley Center, Kansas	Board of Agriculture, Division of Water Resource Application Number:
---	---

3 LOCATE WELL'S LOCATION WITH AN "X" IN SECTION BOX: 	4 DEPTH OF COMPLETED WELL 30 ft. ELEVATION: Depth(s) groundwater Encountered 1 ft. 2 ft. 3 ft. WELL'S STATIC WATER LEVEL 15 FT. BELOW LAND SURFACE MEASURED ON 03/21/1995 Pump test data: Well water was _____ ft. after _____ hours pumping _____ gpm Est. Yield _____ gpm: Well water was _____ ft. after _____ hours pumping _____ gpm Bore Hole Diameter 12 in. to 30 ft. and _____ in. to _____ ft. WELL WATER TO BE USED AS: 5 Public water supply 8 Air conditioning 11 Injection well 1 Domestic 3 Feedlot 6 Oil field water supply 9 Dewatering 12 Other (Specify below) 2 Irrigation 4 Industrial 7 Lawn and garden only 10 Monitoring well Was a chemical/bacteriological sample submitted to Department? Yes _____ No <input checked="" type="checkbox"/> ; If yes, mo/day/yr sample was submitted Water Well Disinfected? Yes <input checked="" type="checkbox"/> No
--	---

5 TYPE OF CASING USED: 1 Steel 3 RMP (SR) 2 PVC 4 ABS	5 Wrought iron 6 Asbestos-Cement 7 Fiberglass	8 Concrete tile CASING JOINTS: Glued <input checked="" type="checkbox"/> Clamped 9 Other (Specify below) SDR-26 Welded Threaded
Blank casing Diameter 5 in. to 20 ft., Dia _____ in. to _____ ft. Casing height above land surface 12 in., weight 2.35 lbs./ft. Wall thickness or gauge No. .214	TYPE OF SCREEN OR PERFORATION MATERIAL: 1 Steel 3 Stainless Steel 5 Fiberglass 2 Brass 4 Galvanized steel 6 Concrete tile 9 ABS	
SCREEN OR PERFORATION OPENING ARE: 1 Continuous slot 3 Mill slot 2 Louvered shutter 4 Key punched	5 Gauzed wrapped 6 Wire wrapped 7 Torch cut	8 Saw cut 11 None (open hole) 9 Drilled holes 10 Other (specify)
SCREEN-PERFORATION INTERVALS: from 20 ft. to 25 ft., From _____ ft. to _____ ft.	GRAVEL PACK INTERVALS: from 20 ft. to 30 ft., From _____ ft. to _____ ft.	

6 GROUT MATERIAL: 1 Neat cement Grout Intervals: From 0 ft. to 20 ft. From _____ ft. to _____ ft.	2 Cement grout 3 Bentonite 4 Other	10 Livestock pens 14 Abandon water well 11 Fuel storage 15 Oil well/Gas well 12 Fertilizer storage 16 Other (specify below) 13 Insecticide storage
What is the nearest source of possible contamination: 1 Septic tank 4 Lateral lines 7 Pit privy 2 Sewer lines 5 Cess pool 8 Sewage lagoon 3 Watertight sewer lines 6 Seepage pit 9 Feedyard	Direction from well? East How many feet? 100	

FROM	TO	LITHOLOGIC LOG	FROM	TO	PLUGGING INTERVALS
0	4	topsoil			
4	12	clay			
12	30	medium sand			

7 CONTRACTOR'S OR LANDOWNER'S CERTIFICATION: This water well was (1) constructed, (2) reconstructed, or (3) plugged under my jurisdiction and was completed on (mo/day/year) **03/21/1995** and this record is true to the best of my knowledge and belief. Kansas Water Well Contractor's License No. **236** This Water Well Record was completed on (mo/day/yr) **04/06/95**
 Under the business name of **Harp Well & Pump Service, Inc** by (signature) *Jane Frederick*