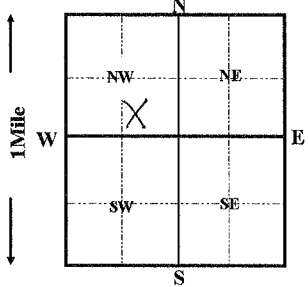


| | | | | |
|--|---|-----------------------------|----------------------------------|---------------------------------|
| 1 LOCATION OF WATER WELL: Sedgwick | FRACTION SW 1/4 SE 1/4 NW 1/4 | Section Number 31 | Township Number T 25 S | Range Number R 1E E/W |
|--|---|-----------------------------|----------------------------------|---------------------------------|

Distance and direction from nearest town or city street address of well if located within city?

520 E. Main Valley Center, Kansas

| | |
|---|---|
| 2 WATER WELL OWNER: QUENZER, Cliff RR#, ST. ADDRESS, BOX #: 520 E. Main CITY, STATE, ZIP CODE: Valley Center, Kansas | Board of Agriculture, Division of Water Resource Application Number: |
|---|---|

| | |
|--|---|
| 3 LOCATE WELL'S LOCATION WITH AN "X" IN SECTION BOX:  | 4 DEPTH OF COMPLETED WELL 35 ft. ELEVATION: Depth(s) groundwater Encountered 1 ft. 2 ft. 3 ft. WELL'S STATIC WATER LEVEL 15 FT. BELOW LAND SURFACE MEASURED ON 05/11/1995 Pump test data: Well water was _____ ft. after _____ hours pumping _____ gpm Est. Yield _____ gpm: Well water was _____ ft. after _____ hours pumping _____ gpm Bore Hole Diameter 12 in. to 35 ft. and _____ in. to _____ ft. WELL WATER TO BE USED AS: 5 Public water supply 8 Air conditioning 11 Injection well 1 Domestic 3 Feedlot 6 Oil field water supply 9 Dewatering 12 Other (Specify below) 2 Irrigation 4 Industrial 7 Lawn and garden only 10 Monitoring well Was a chemical/bacteriological sample submitted to Department? Yes _____ No <input checked="" type="checkbox"/> ; If yes, mo/day/yr sample was submitted _____ Water Well Disinfected? Yes <input checked="" type="checkbox"/> No _____ |
|--|---|

| | | |
|--|--|--|
| 5 TYPE OF CASING USED: 1 Steel 3 RMP (SR) 2 PVC 4 ABS | 5 Wrought iron 8 Concrete tile 6 Asbestos-Cement 9 Other (Specify below) 7 Fiberglass | CASING JOINTS: Glued <input checked="" type="checkbox"/> Clamped Welded Threaded |
| Blank casing Diameter 5 in. to 24 ft., Dia _____ in. to _____ ft. Casing height above land surface 12 in., weight 2.35 lbs. / ft. Wall thickness or gauge No. .214 | TYPE OF SCREEN OR PERFORATION MATERIAL: 1 Steel 3 Stainless Steel 5 Fiberglass 8 RMP (SR) 2 Brass 4 Galvanized steel 6 Concrete tile 9 ABS 10 Asbestos-cement 11 other (specify) | |
| SCREEN OR PERFORATION OPENING ARE: 1 Continuous slot 3 Mill slot 2 Louvered shutter 4 Key punched | 5 Gauzed wrapped 8 Saw cut 11 None (open hole) 6 Wire wrapped 7 Torch cut 9 Drilled holes 10 Other (specify) | |
| SCREEN-PERFORATION INTERVALS: from 24 ft. to 32 ft., From _____ ft. to _____ ft. | GRAVEL PACK INTERVALS: from 24 ft. to 35 ft., From _____ ft. to _____ ft. | |

| | | |
|--|--|--|
| 6 GROUT MATERIAL: 1 Neat cement Grout Intervals: From 4 ft. to 24 ft. From _____ ft. to _____ ft. | 2 Cement grout 3 Bentonite 4 Other | 10 Livestock pens 14 Abandon water well 11 Fuel storage 15 Oil well/Gas well 12 Fertilizer storage 16 Other (specify below) 13 Insecticide storage |
| What is the nearest source of possible contamination: 1 Septic tank 4 Lateral lines 7 Pit privy 2 Sewer lines 5 Cess pool 8 Sewage lagoon 3 Watertight sewer lines 6 Seepage pit 9 Feedyard | | |
| Direction from well? West | | How many feet? 50 |

| FROM | TO | LITHOLOGIC LOG | FROM | TO | PLUGGING INTERVALS |
|------|----|----------------|------|----|--------------------|
| 0 | 3 | topsoil | | | |
| 3 | 18 | clay | | | |
| 18 | 25 | fine sand | | | |
| 25 | 32 | medium sand | | | |
| 32 | 35 | grey clay | | | |
| | | | | | |
| | | | | | |
| | |
|--|-----------------------|
| 7 CONTRACTOR'S OR LANDOWNER'S CERTIFICATION: This water well was (1) constructed, (2) reconstructed, or (3) plugged under my jurisdiction and was completed on (mo/day/year) 05/11/1995 and this record is true to the best of my knowledge and belief. Kansas Water Well Contractor's License No. 236 This Water Well Record was completed on (mo/day/yr) 05/19/95 Under the business name of Harp Well & Pump Service, Inc by (signature) _____ | <i>Jane Frederick</i> |
|--|-----------------------|