


1] LOCATION OF WATER WELL: Fraction NW 1/4 SE 1/4 SW 1/4 Section Number 18 Township Number 25 S Range Number 10 E/W
 County Sedgwick
 Distance and direction from nearest town or city, street address of well if located within city?

1750 N. 93rd St.

2] WATER WELL OWNER: Ed Wray
 RR#, St. Address, Box #: P.O. Box 99
 City, State, ZIP Code: Sedgwick, KS 67135
 Board of Agriculture, Division of Water Resources
 Application Number:

3] LOCATE WELL'S LOCATION WITH AN "X" IN SECTION BOX:

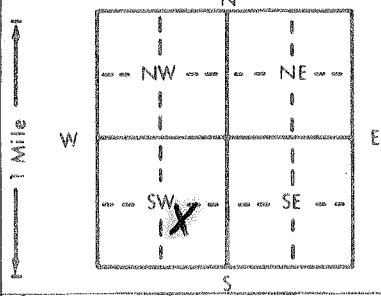

4] DEPTH OF COMPLETED WELL... 66 ft. ELEVATION: ... ft.

Depth(s) Groundwater Encountered 48 ft. 2. ... ft. 3. ... ft.
 WELL'S STATIC WATER LEVEL 48 ft. below land surface measured on mo/day/yr
 Pump test data: Well water was ... ft. after ... hours pumping ... gpm
 Est. Yield 15-18 gpm. Well water was ... ft. after ... hours pumping ... gpm
 Bore Hole Diameter... 11 in. to 66 ft., and ... in. to ... ft.
 WELL WATER TO BE USED AS:
 1 Domestic 3 Feedlot 6 Oil field water supply 9 Dewatering 12 Other (Specify below)
 2 Irrigation 4 Industrial 7 Lawn and garden only 10 Monitoring well

Was a chemical/bacteriological sample submitted to Department? Yes... No X...; If yes, mo/day/yr sample was submitted
 Water Well Disinfected? Yes X No

5] TYPE OF BLANK CASING USED:
 1 Steel 3 RMP (SR)
 2 PVC 4 ABS
 5 Wrought iron 8 Concrete tile CASING JOINTS: Glued X Clamped ...
 6 Asbestos-Cement 9 Other (specify below) Welded ...
 7 Fiberglass Threaded ...

Blank casing diameter 5 in. to 53 ft., Dia ... in. to ... ft., Dia ... in. to ... ft.
 Casing height above land surface... 12 in., weight 2.60 lbs./ft. Wall thickness or gauge No. 100 PSI

TYPE OF SCREEN OR PERFORATION MATERIAL:
 1 Steel 3 Stainless steel 5 Fiberglass 7 PVC 10 Asbestos-cement
 2 Brass 4 Galvanized steel 6 Concrete tile 8 RMP (SR) 11 Other (specify) ...
 12 None used (open hole)

SCREEN OR PERFORATION OPENINGS ARE:
 1 Continuous slot 3 Mill slot
 2 Louvered shutter 4 Key punched 5 Gauzed wrapped 8 Saw cut 11 None (open hole)
 6 Wire wrapped 9 Drilled holes
 7 Torch cut 10 Other (specify) ...

SCREEN-PERFORATED INTERVALS: From 33 ft. to 66 ft., From ... ft. to ... ft.
 From 33 ft. to 66 ft., From ... ft. to ... ft.
 GRAVEL PACK INTERVALS: From 48 ft. to 66 ft., From ... ft. to ... ft.
 From 48 ft. to 66 ft., From ... ft. to ... ft.

6] GROUT MATERIAL: 1 Neat cement 2 Cement grout 3 Bentonite 4 Other
 Grout Intervals: From 10 ft. to 48 ft., From ... ft. to ... ft., From ... ft. to ... ft.

What is the nearest source of possible contamination:
 1 Septic tank 4 Lateral lines 7 Pit privy 10 Livestock pens 14 Abandoned water well
 2 Sewer lines 5 Cess pool 8 Sewage lagoon 11 Fuel storage 15 Oil well/Gas well
 3 Watertight sewer lines 6 Seepage pit 9 Feedyard 12 Fertilizer storage 16 Other (specify below)
 13 Insecticide storage

Direction from well? How many feet?

| FROM | TO | LITHOLOGIC LOG | FROM | TO | PLUGGING INTERVALS |
|------|----|---------------------|------|----|--------------------|
| 0 | 48 | clay | | | |
| 48 | 51 | fine sand | | | |
| 51 | 60 | medium sand & shale | | | |
| 60 | 66 | clay | | | |

7] CONTRACTOR'S OR LANDOWNER'S CERTIFICATION: This water well was (1) constructed, (2) reconstructed, or (3) plugged under my jurisdiction and was completed on (mo/day/year) 3-29-95 and this record is true to the best of my knowledge and belief. Kansas Water Well Contractor's License No. 318 This Water Well Record was completed on (mo/day/yr) 3-30-95 under the business name of Weninger Drilling, Inc by (signature) Harvina Morrison