


1 LOCATION OF WATER WELL: Sedgwick	FRACTION SW 1/4 SE 1/4 NW 1/4	Section Number 31	Township Number T 25 S	Range Number R 1E E/W
--	---	-----------------------------	----------------------------------	---------------------------------

Distance and direction from nearest town or city street address of well if located within city?
123 N. Emporia Valley Center, Kansas

2 WATER WELL OWNER: MILLER, George RR#, ST. ADDRESS, BOX #: 123 N. Emporia CITY, STATE, ZIP CODE: Valley Center, Kansas 67147	Board of Agriculture, Division of Water Resource Application Number:
--	---

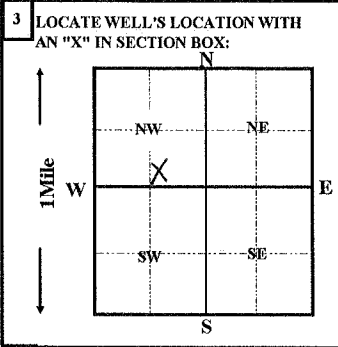


Was a chemical/bacteriological sample submitted to Department? Yes <input type="checkbox"/> No <input checked="" type="checkbox"/> ; If yes, mo/day/yr sample was submitted	
Water Well Disinfected? Yes <input checked="" type="checkbox"/> No <input type="checkbox"/>	

5 TYPE OF CASING USED:	1 Steel 3 RMP (SR) 5 Wrought iron 8 Concrete tile CASING JOINTS: Glued Clamped 2 PVC 4 ABS 6 Asbestos-Cement 9 Other (Specify below) Welded 7 Fiberglass Threaded X
TYPE OF SCREEN OR PERFORATION MATERIAL:	1 Steel 3 Stainless Steel 5 Fiberglass 8 RMP (SR) 11 other (specify) 2 Brass 4 Galvanized steel 6 Concrete tile 9 ABS 12 None used (open hole)
SCREEN OR PERFORATION OPENING ARE:	1 Continuous slot 3 Mill slot 5 Gauzed wrapped 8 Saw cut 11 None (open hole) 2 Louvered shutter 4 Key punched 6 Wire wrapped 9 Drilled holes 7 Torch cut 10 Other (specify)

What is the nearest source of possible contamination:	1 Septic tank 4 Lateral lines 7 Pit privy 10 Livestock pens 14 Abandon water well 2 Sewer lines 5 Cess pool 8 Sewage lagoon 11 Fuel storage 15 Oil well/Gas well 3 Watertight sewer lines 6 Seepage pit 9 Feedyard 12 Fertilizer storage 16 Other (specify below) 13 Insecticide storage
Direction from well? North	How many feet? 12

FROM	TO	LITHOLOGIC LOG	FROM	TO	PLUGGING INTERVALS
			0	10	cement grout and bentonite hole plug
			10	28	chlorinated sand and gravel

7 CONTRACTOR'S OR LANDOWNER'S CERTIFICATION: This water well was (1) constructed, (2) reconstructed, or (3) plugged under my jurisdiction and was completed on (mo/day/year) 05/22/1995 and this record is true to the best of my knowledge and belief. Kansas Water Well Contractor's License No. 236 . This Water Well Record was completed on (mo/day/yr) 05/23/95 . Under the business name of Harp Well & Pump Service, Inc by (signature)	<i>Jane Frederick</i>
---	-----------------------