USE TYPEWRITER OR BALL POINT PEN-PRESS FIRMLY, PRINT CLEARLY.

WATER WELL RECORD
KSA 82a-1201-1215

Kansas Department of Health and Environment-Division of Environment
(Water well Contractors)
Topeka, Kansas 66620

1. Location of well:	County	Fraction	Section number	Township number	Range number
	WILSON	NW 1/4 NW 1/4 NW 1/4	26	T 25 S	R 14 E/W

2. Distance and direction from nearest town or city: 5 MI. WEST
Street address of well location if in city: 1 SOUTH YATES CENTER

3. Owner of well: WILLARD WEIDE
X R. or street: RFD #4
City, state, zip code: YATES CENTER

4. Locate with "X" in section below:

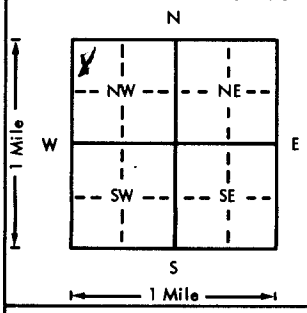

Sketch map:

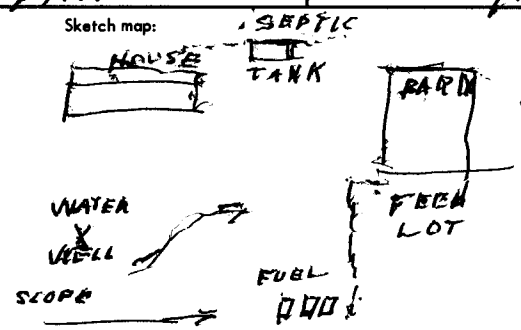

6. Bore hole dia. 7 in. Completion date 4/22/79
Well depth 150 ft.

X Cable tool __ Rotary __ Driven __ Dug
__ Hollow rod __ Jetted __ Bored __ Reverse rotary

8. Use: X Domestic __ Public supply __ Industry
__ Irrigation __ Air conditioning __ Stock
__ Lawn __ Oil field water __ Other

9. Casing: Material PVC Height: Above or below
Threaded ___ Welded GL Surface 14 in.
RMP ___ PVC X Weight ___ lbs./ft.
Dia. 6 in. to 150 ft. depth Wall Thickness: inches or
Dia. ___ in. to ___ ft. depth gage No. 0.280

10. Screen: Manufacturer's name JESS LOWELL
Type PVC Dia. 6
Slot/gauze 1/16 Length 65
Set between 119 ft. and 140 ft.
1 ft. and ___ ft.
Gravel pack? X NO Size range of material

11. Static water level: mo./day/yr.
60 ft. below land surface Date 4/22/79

12. Pumping level below land surfaces:
___ ft. after ___ hrs. pumping ___ g.p.m.
___ ft. after ___ hrs. pumping ___ g.p.m.
Estimated maximum yield 10 g.p.m.

13. Water sample submitted: mo./day/yr.
__ Yes X No Date

14. Well head completion:
__ Pitless adapter 14 Inches above grade

15. Well grouted? X
With: __ Neat cement __ Bentonite X Concrete
Depth: From 0 ft. to 15 ft.

16. Nearest source of possible contamination: SEPTIC
ft. ___ Direction NEAST Type TANK
Well disinfected upon completion? X Yes ___ No

17. Pump: X Not installed
Manufacturer's name
Model number ___ HP ___ Volts ___
Length of drop pipe ___ ft. capacity ___ g.p.m.
Type:
__ Submersible __ Turbine
__ Jet __ Reciprocating
__ Centrifugal __ Other

5. Type and color of material

	From	To
BLACK SOIL	0	3
RED CLAY	3	10
LIGHT GREEN SHALE	10	16
GREY LIME	16	27
DARK SHALE	27	46
RED CLAY	46	49
BROWN LIME	49	54
GREY SHALE	54	66
WHITE SAND	66	84
GREY SHALE	84	86
WHITE SAND	86	97
GREY SHALE	97	103
GREY SAND	103	115
WHITE SAND	115	141
GREY LIME	141	146
BLUE SHALE (Use a second sheet if needed)	146	150

18. Elevation:

Topography:
__ Hill
__ Slope
X Upland
__ Valley

19. Remarks: MR WEIDE IS GOING TO RUN THE PUMP AND BUILD THE WELL HOUSE

20. Water well contractor's certification:
This well was drilled under my jurisdiction and this report is true to the best of my knowledge and belief.
Business name CUMMINGS WELL SERV License No. 312
Address TOPONTO KAN
Signed [signature] Date 4/30
Authorized representative

25 14 E 26 NWNW
T R Sec 1/4 1/4 1/4

Forward the white, blue and pink copies to the Department of Health and Environment

Form WWC-5

MI-1023