


1 LOCATION OF WATER WELL: County: Woodson Fraction: NW 1/4 NW 1/4 NW 1/4 Section Number: 3 Township Number: T 25 S Range Number: R 15 EW

Distance and direction from nearest town or city street address of well if located within city?
2 MI. N. AND 1 W. OF YATES CENTER

2 WATER WELL OWNER: JIM KNAPP RR#, St. Address, Box #: Rt. 4 City, State, ZIP Code: YATES CENTER Board of Agriculture, Division of Water Resources Application Number:

3 LOCATE WELL'S LOCATION WITH AN "X" IN SECTION BOX:

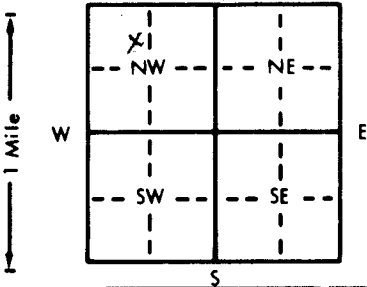

4 DEPTH OF COMPLETED WELL: 90 ft. ELEVATION: Depth(s) Groundwater Encountered 1. 16 ft. 2. ft. 3. ft. WELL'S STATIC WATER LEVEL: 7 ft. below land surface measured on mo/day/yr 9/9/83 Pump test data: Well water was ft. after hours pumping gpm Est. Yield 2 gpm: Well water was ft. after hours pumping gpm Bore Hole Diameter: 7 in. to ft., and in. to ft. WELL WATER TO BE USED AS: 5 Public water supply 8 Air conditioning 11 Injection well 1 Domestic 3 Feedlot 6 Oil field water supply 9 Dewatering 12 Other (Specify below) 2 Irrigation 4 Industrial 7 Lawn and garden only 10 Observation well Was a chemical/bacteriological sample submitted to Department? Yes No ; If yes, mo/day/yr sample was submitted Water Well Disinfected? Yes No

5 TYPE OF BLANK CASING USED: 1 Steel 3 RMP (SR) 5 Wrought iron 8 Concrete tile CASING JOINTS: Glued Clamped Welded Threaded 2 PVC 4 ABS 6 Asbestos-Cement 9 Other (specify below) 7 Fiberglass

Blank casing diameter: 6 in. to 10 ft., Dia: 1 in. to 30 ft., Dia: 6 in. to 90 ft. Casing height above land surface: 6 in., weight lbs./ft. Wall thickness or gauge No. 275

TYPE OF SCREEN OR PERFORATION MATERIAL: 1 Steel 3 Stainless steel 5 Fiberglass 8 RMP (SR) 10 Asbestos-cement 2 Brass 4 Galvanized steel 6 Concrete tile 9 ABS 11 Other (specify) 12 None used (open hole) 7 PVC

SCREEN OR PERFORATION OPENINGS ARE: 1 Continuous slot 3 Mill slot 5 Gauzed wrapped 8 Saw cut 11 None (open hole) 2 Louvered shutter 4 Key punched 6 Wire wrapped 9 Drilled holes 10 Other (specify) 7 Torch cut

SCREEN-PERFORATED INTERVALS: From 10 ft. to 30 ft., From ft. to ft. GRAVEL PACK INTERVALS: From ft. to ft., From ft. to ft.

6 GROUT MATERIAL: 1 Neat cement 2 Cement grout 3 Bentonite 4 Other Grout Intervals: From ft. to ft., From ft. to ft.

What is the nearest source of possible contamination: 1 Septic tank 4 Lateral lines 7 Pit privy 10 Livestock pens 14 Abandoned water well 2 Sewer lines 5 Cess pool 8 Sewage lagoon 11 Fuel storage 15 Oil well/Gas well 3 Watertight sewer lines 6 Seepage pit 9 Feedyard 12 Fertilizer storage 16 Other (specify below) 13 Insecticide storage Direction from well? SOUTH How many feet? 300

FROM	TO	LITHOLOGIC LOG	FROM	TO	LITHOLOGIC LOG
0	4	TOP SOIL			
4	16	SAND ROCK			
16	19	SOAPSTONE			
19	90	KEY SHALE			

7 CONTRACTOR'S OR LANDOWNER'S CERTIFICATION: This water well was (1) constructed, (2) reconstructed, or (3) plugged under my jurisdiction and was completed on (mo/day/year) 9/8/83 and this record is true to the best of my knowledge and belief. Kansas Water Well Contractor's License No. 912 This Water Well Record was completed on (mo/day/yr) 9/9/83 under the business name of CUMMINGS WELL SERV. by (signature) [Signature]

INSTRUCTIONS: Use typewriter or ball point pen, PLEASE PRESS FIRMLY and PRINT clearly. Please fill in blanks, underline or circle the correct answers. Send top three copies to Kansas Department of Health and Environment, Division of Environment, Environmental Geology Section, Topeka, KS 66620. Send one to WATER WELL OWNER and retain one for your records.

OFFICE USE ONLY

T

25

R

15

EW

SEC.

3

NW 1/4

NW 1/4

NW 1/4

NW 1/4

DP