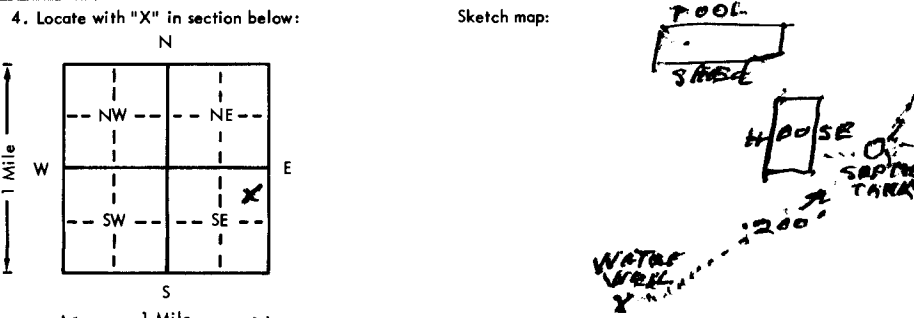


USE TYPEWRITER OR BALL POINT PEN-PRESS FIRMLY, PRINT CLEARLY.

WATER WELL RECORD
KSA 82a-1201-1215

Kansas Department of Health and Environment-Division of Environment
(Water well Contractors)
Topeka, Kansas 66620

1. Location of well: County W.D. WOODSON Fraction NE 1/4 NE 1/4 SE 1/4 Section number 6 Township number T 25 S R 15 E/W Range number	
2. Distance and direction from nearest town or city: 4 MI. W. OF YATES CENTER 2-N. 3. Owner of well: LEO WILLIAMS P.R. or street: RT#4 City, state, zip code: KANSAS CITY MO 64118	
4. Locate with "X" in section below: Sketch map: 	
5. Type and color of material	
	From To
BLACK SOIL	0 3
BROWN CLAY	3 9
YELLOW CLAY	9 15
YELLOW CLAY LIGHT	15 21
GRAY SHALE	21 26
LIGHT SANDY SHALE	26 32
WHITE SAND ← S.O.W.	32 46
GRAY SHALE	46 67
(Use a second sheet if needed)	
18. Elevation: Topography: <input type="checkbox"/> Hill <input checked="" type="checkbox"/> Slope <input type="checkbox"/> Upland <input type="checkbox"/> Valley	19. Remarks: MR. WILLIAMS IS RUNNING HIS OWN PUMP
20. Water well contractor's certification: This well was drilled under my jurisdiction and this report is true to the best of my knowledge and belief. LUMMINGS WELL SERV 312 Business name: TOPOTO KAN License No. Address: Topoto Kan Signed: [Signature] Date: 4/13/78 Authorized representative	

25 150 W 6 NE NESE
T
R
Sec
1/4 1/4 1/4

Forward the white, blue and pink copies to the Department of Health and Environment

Form WWC-5