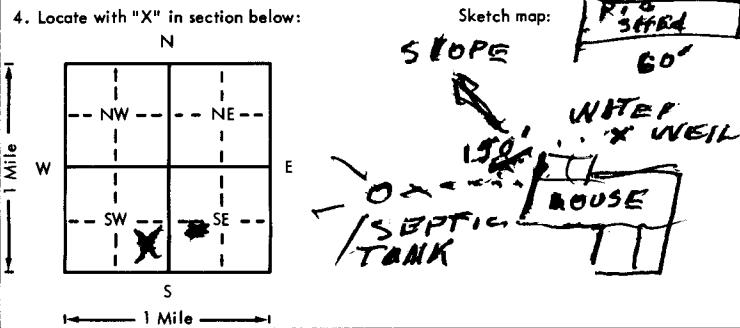


USE TYPEWRITER OR BALL POINT PEN-PRESS FIRMLY, PRINT CLEARLY.

WATER WELL RECORD  
KSA 82a-1201-1215

Kansas Department of Health and Environment-Division of Environment (Water well Contractors) Topeka, Kansas 66620

1. Location of well: County <b>Woodson</b> Fraction <b>S 1/2 SW 1/4</b> Section number <b>9</b> Township number <b>T 25 S R 15</b> Range number <b>15</b> E/W	
2. Distance and direction from nearest town or city: <b>1 1/2 MI W</b> Street address of well location if in city: <b>Y.C. 1/2 MI N</b> 3. Owner of well: <b>JERRY MENTZER RT. #4</b> R.R. or street: <b>YATE CENTER</b> City, state, zip code: <b>YATE CENTER</b>	
4. Locate with "X" in section below: Sketch map: 	
6. Bore hole dia. <b>7</b> in. Completion date <b>3/20/98</b> Well depth <b>90</b> ft.	
7. <input checked="" type="checkbox"/> Cable tool <input type="checkbox"/> Rotary <input type="checkbox"/> Driven <input type="checkbox"/> Dug <input type="checkbox"/> Hollow rod <input type="checkbox"/> Jetted <input type="checkbox"/> Bored <input type="checkbox"/> Reverse rotary	
8. Use: <input checked="" type="checkbox"/> Domestic <input type="checkbox"/> Public supply <input type="checkbox"/> Industry <input type="checkbox"/> Irrigation <input type="checkbox"/> Air conditioning <input type="checkbox"/> Stock <input type="checkbox"/> Lawn <input type="checkbox"/> Oil field water <input type="checkbox"/> Other	
9. Casing: Material <b>PETS</b> Height: Above or below Threading <b>GL</b> Surface <b>M</b> in. RMP <b>PVC</b> Weight <b>12</b> lbs./ft. Dia. <b>6</b> in. to <b>90</b> ft. depth Wall Thickness: inches or Dia. <b>12</b> in. to <b>90</b> ft. depth gage No. <b>1200</b>	
10. Screen: Manufacturer's name <b>JESS LOWELL</b> Type <b>PVC</b> Dia. <b>6</b> Slot/gauze <b>1/4</b> Length <b>30</b> Set between <b>30</b> ft. and <b>50</b> ft. Gravel pack? <input checked="" type="checkbox"/> No Size range of material <input checked="" type="checkbox"/>	
11. Static water level: <b>12</b> ft. below land surface Date <b>3/20/98</b> mo./day/yr.	
12. Pumping level below land surfaces: <b>30</b> ft. after <b>30</b> hrs. pumping <b>30</b> g.p.m. Estimated maximum yield <b>30</b> g.p.m.	
13. Water sample submitted: <input checked="" type="checkbox"/> Yes <input type="checkbox"/> No Date	
14. Well head completion: <b>12</b> Pitless adapter <b>12</b> Inches above grade	
15. Well grouted? <input checked="" type="checkbox"/> With: <input type="checkbox"/> Neat cement <input type="checkbox"/> Bentonite <input checked="" type="checkbox"/> Concrete Depth: From <b>10</b> ft. to <b>14</b> ft.	
16. Nearest source of possible contamination: <b>60</b> ft. <b>60</b> Direction <b>N</b> Type <b>SHED</b> Well disinfected upon completion? <input checked="" type="checkbox"/> Yes <input type="checkbox"/> No	
17. Pump: <input checked="" type="checkbox"/> Not installed Manufacturer's name Model number HP Volts Length of drop pipe ft. capacity g.p.m. Type: <input type="checkbox"/> Submersible <input type="checkbox"/> Turbine <input type="checkbox"/> Jet <input type="checkbox"/> Reciprocating <input type="checkbox"/> Centrifugal <input type="checkbox"/> Other	
(Use a second sheet if needed)	
18. Elevation: Topography: <input checked="" type="checkbox"/> Hill <input checked="" type="checkbox"/> Slope <input type="checkbox"/> Upland <input type="checkbox"/> Valley	19. Remarks: <b>MR. MENTZER RAN HIS OWN PUMP</b>
20. Water well contractor's certification: This well was drilled under my jurisdiction and this report is true to the best of my knowledge and belief. <b>CONNING'S WELL SERV 312</b> Business name License No. Address <b>TOPEKA KAN</b> Signed <b>Ken Conning</b> Date <b>3/25/98</b> Authorized representative	

T 25 S R 15 Sec 9 SW 1/4