


1 LOCATION OF WATER WELL: County: WOODSON Fraction: SW 1/4 NW 1/4 NW 1/4 Section Number: 11 Township Number: T 25 S Range Number: R 15 EW

Distance and direction from nearest town or city street address of well if located within city?  
310 WEST BELL STREET YATES CENTER, KS

2 WATER WELL OWNER: BETTY ADAMS  
 RR#, St. Address, Box #: 310 W BELL  
 City, State, ZIP Code: YATES CENTER, KS 66783  
 Board of Agriculture, Division of Water Resources  
 Application Number:

3 LOCATE WELL'S LOCATION WITH AN "X" IN SECTION BOX:

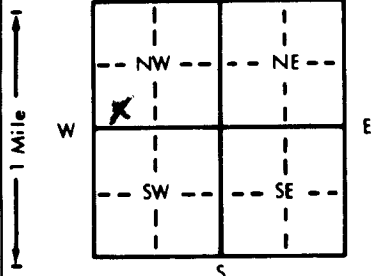

4 DEPTH OF COMPLETED WELL: 60 ft. ELEVATION: 5  
 Depth(s) Groundwater Encountered 1. 3.5 ft. 2. ... ft. 3. ... ft.  
 WELL'S STATIC WATER LEVEL 17 ft. below land surface measured on mo/day/yr 8/17/91  
 Pump test data: Well water was ... ft. after ... hours pumping ... gpm  
 Est. Yield 8 gpm: Well water was ... ft. after ... hours pumping ... gpm  
 Bore Hole Diameter 8 in. to 60 ft., and ... in. to ... ft.

WELL WATER TO BE USED AS:  
 1 Domestic 2 Irrigation 3 Feedlot 4 Industrial 5 Public water supply 6 Oil field water supply 7 Lawn and garden only 8 Air conditioning 9 Dewatering 10 Monitoring well 11 Injection well 12 Other (Specify below)  
 Was a chemical/bacteriological sample submitted to Department? Yes. ... No. X ...; If yes, mo/day/yr sample was submitted  
 Water Well Disinfected? Yes X No

5 TYPE OF BLANK CASING USED:  
 1 Steel 2 PVC 3 RMP (SR) 4 ABS 5 Wrought iron 6 Asbestos-Cement 7 Fiberglass 8 Concrete tile 9 Other (specify below) 10 Asbestos-cement CASING JOINTS: Glued ... Clamped ... Welded ... Threaded ...

Blank casing diameter 5 in. to 40 ft., Dia. ... in. to ... ft., Dia. ... in. to ... ft.  
 Casing height above land surface ... in., weight ... lbs./ft. Wall thickness or gauge No. ...

TYPE OF SCREEN OR PERFORATION MATERIAL:  
 1 Steel 2 Brass 3 Stainless steel 4 Galvanized steel 5 Fiberglass 6 Concrete tile 7 PVC 8 RMP (SR) 9 ABS 10 Asbestos-cement 11 Other (specify) 12 None used (open hole)

SCREEN OR PERFORATION OPENINGS ARE:  
 1 Continuous slot 2 Louvered shutter 3 Mill slot 4 Key punched 5 Gauzed wrapped 6 Wire wrapped 7 Torch cut 8 Saw cut 9 Drilled holes 10 Other (specify) 11 None (open hole)

SCREEN-PERFORATED INTERVALS: From 40 ft. to 60 ft., From ... ft. to ... ft.  
 GRAVEL PACK INTERVALS: From 20 ft. to 60 ft., From ... ft. to ... ft.

6 GROUT MATERIAL: 1 Neat cement 2 Cement grout 3 Bentonite 4 Other ...  
 Grout Intervals: From 0 ft. to 20 ft., From ... ft. to ... ft., From ... ft. to ... ft.

What is the nearest source of possible contamination:  
 1 Septic tank 2 Sewer lines 3 Watertight sewer lines 4 Lateral lines 5 Cess pool 6 Seepage pit 7 Pit privy 8 Sewage lagoon 9 Feedyard 10 Livestock pens 11 Fuel storage 12 Fertilizer storage 13 Insecticide storage 14 Abandoned water well 15 Oil well/Gas well 16 Other (specify below)

Direction from well? How many feet? 150

FROM	TO	LITHOLOGIC LOG	FROM	TO	PLUGGING INTERVALS
0	3	SILT			
3	35	SANDSTONE			
35	60	GRAY SHALE			

7 CONTRACTOR'S OR LANDOWNER'S CERTIFICATION: This water well was (1) constructed, (2) reconstructed, or (3) plugged under my jurisdiction and was completed on (mo/day/year) 8-17-91 and this record is true to the best of my knowledge and belief. Kansas Water Well Contractor's License No. 5.P.1 This Water Well Record was completed on (mo/day/yr) 11/15/91 under the business name of Callie Water Well Service by (signature) Hermit M. Callie

INSTRUCTIONS: Use typewriter or ball point pen. PLEASE PRESS FIRMLY and PRINT clearly. Please fill in blanks, underline or circle the correct answers. Send top three copies to Kansas Department of Health and Environment, Bureau of Water, Topeka, Kansas 66620-0001. Telephone: 913-296-5545. Send one to WATER WELL OWNER and retain one for your records.

OFFICE USE ONLY  
 T  
 R  
 EW  
 SEC.  
 1/4  
 1/4  
 1/4