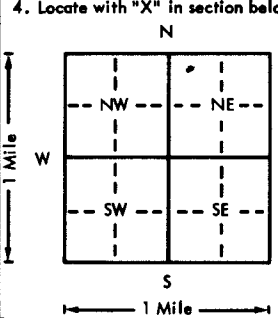
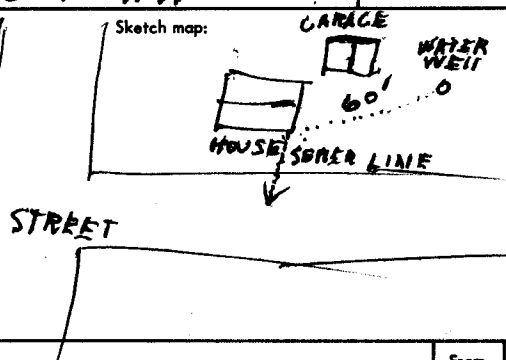


USE TYPEWRITER OR BALL POINT PEN—PRESS FIRMLY, PRINT CLEARLY.

WATER WELL RECORD
KSA 82a-1201-1215

Kansas Department of Health and Environment—Division of Environment
(Water well Contractors)
Topeka, Kansas 66620

1. Location of well: County <u>Woodson</u> <u>W.O.</u>		Fraction <u>NW 1/4 NE 1/4</u>		Section number <u>14</u>	Township number T <u>25</u> S R <u>15</u> E/W	Range number
2. Distance and direction from nearest town or city: Street address of well location if in city: <u>309 W. WILSON</u>				3. Owner of well: <u>WE ALLISON</u> R.R. or street: <u>309 W. WILSON</u> City, state, zip code: <u>YATES CENTER KAN</u>		
4. Locate with "X" in section below: 		Sketch map: 		6. Bore hole dia. <u>4</u> in. Completion date <u>7/30/76</u> Well depth <u>60</u> ft.		
5. Type and color of material		From	To	7. <input checked="" type="checkbox"/> Cable tool <input type="checkbox"/> Rotary <input type="checkbox"/> Driven <input type="checkbox"/> Dug <input type="checkbox"/> Hollow rod <input type="checkbox"/> Jetted <input type="checkbox"/> Bored <input type="checkbox"/> Reverse rotary		
<u>dark soil</u>		<u>0</u>	<u>3</u>	8. Use: <input type="checkbox"/> Domestic <input type="checkbox"/> Public supply <input type="checkbox"/> Industry <input type="checkbox"/> Irrigation <input type="checkbox"/> Air conditioning <input type="checkbox"/> Stock <input checked="" type="checkbox"/> Lawn <input type="checkbox"/> Oil field water <input type="checkbox"/> Other		
<u>yellow clay</u>		<u>3</u>	<u>6</u>	9. Casing: Material <u>PVS</u> Height: <u>60</u> or below Threaded <input type="checkbox"/> Welded <input type="checkbox"/> Surface <u>14</u> in. RMP <input type="checkbox"/> PVC <input type="checkbox"/> Weight <u>380</u> lbs./ft. Dia. <u>6</u> in. to <u>20</u> ft. depth; Wall Thickness: inches or Dia. <u>6</u> in. to <u>20</u> ft. depth; gage No. <u>225</u>		
<u>brown sandy clay</u>		<u>6</u>	<u>8</u>	<input checked="" type="checkbox"/> Screen: Manufacturer's name <u>JESS LOWELL</u> Type <u>PVC</u> Dia. <u>6</u> Slot/gauze <u>1/4</u> Length <u>10</u> Set between <u>30</u> ft. and <u>40</u> ft. ft. and <u> </u> ft. Gravel pack? <u>NO</u> Size range of material <u> </u>		
<u>brown sand rock</u>		<u>8</u>	<u>14</u>	11. Static water level: <u> </u> mo./day/yr. <u>12</u> ft. below land surface Date <u>7/19/76</u>		
<u>grey sand rock 200' NO'</u>		<u>14</u>	<u>22</u>	12. Pumping level below land surfaces: <u> </u> ft. after <u> </u> hrs. pumping <u> </u> g.p.m. <u> </u> ft. after <u> </u> hrs. pumping <u> </u> g.p.m. Estimated maximum yield <u>50</u> g.p.m.		
<u>yellow sand rock</u>		<u>22</u>	<u>35</u>	13. Water sample submitted: <u> </u> mo./day/yr. Yes <input type="checkbox"/> No <input checked="" type="checkbox"/> Date <u> </u>		
<u>brown sand rock 800' NO'</u>		<u>35</u>	<u>42</u>	14. Well head completion: <input checked="" type="checkbox"/> Pitless adapter <u>12</u> inches above grade		
<u>grey rock</u>		<u>42</u>	<u>43</u>	15. Well grouted? <u>YES</u> With: <input checked="" type="checkbox"/> Neat cement <input type="checkbox"/> Bentonite <input type="checkbox"/> Concrete Depth: From <u>0</u> ft. to <u>16</u> ft.		
<u>white sand rock</u>		<u>43</u>	<u>47</u>	16. Nearest source of possible contamination: ft. <u>WEST</u> Direction <u>60</u> Type <u>SAWER</u> Well disinfected upon completion? <input checked="" type="checkbox"/> Yes <input type="checkbox"/> No		
<u>grey rock</u>		<u>47</u>	<u>54</u>	17. Pump: <input checked="" type="checkbox"/> Not installed Manufacturer's name <u> </u> Model number <u> </u> HP <u> </u> Volts <u> </u> Length of drop pipe <u> </u> ft. capacity <u> </u> g.p.m. Type: <input type="checkbox"/> Submersible <input type="checkbox"/> Turbine <input type="checkbox"/> Jet <input type="checkbox"/> Reciprocating <input type="checkbox"/> Centrifugal <input type="checkbox"/> Other		
<u>white sand rock</u>		<u>54</u>	<u>58</u>	18. Elevation: Topography: <input type="checkbox"/> Hill <input type="checkbox"/> Slope <input checked="" type="checkbox"/> Upland <input type="checkbox"/> Valley		
<u>grey shale</u>		<u>58</u>	<u>60</u>	19. Remarks: <u>MR ALLISON IS RUNNING HIS OWN PUMP. HE KNOWS WHAT IS REQUIRED.</u>		
				20. Water well contractor's certification: This well was drilled under my jurisdiction and this report is true to the best of my knowledge and belief. <u>TUMMINGS WELL SERV 312</u> Business name <u>TORONTO KAN</u> License No. <u> </u> Address <u> </u> Signed <u> </u> Date <u>8/14/76</u> Authorized representative		

25 250 14 NW NE

Forward the white, blue and pink copies to the Department of Health and Environment

Form WWC-5