


1 LOCATION OF WATER WELL: Fraction SW 1/4 SW 1/4 SW 1/4 Section Number 16 Township Number T 25 S Range Number R 18 E
 County: ALLEN
 Distance and direction from nearest town or city street address of well if located within city? 4 Miles North of Humboldt Kansas and 300 ft East of Hwy 169

2 WATER WELL OWNER: Wayne Riebel
 RR#, St. Address, Box #: 4th and Washington
 City, State, ZIP Code: Harpers, Ks.
 Board of Agriculture, Division of Water Resources
 Application Number:

3 LOCATE WELL'S LOCATION WITH AN "X" IN SECTION BOX: 4 DEPTH OF COMPLETED WELL: 71 ft. ELEVATION: 98 ft.

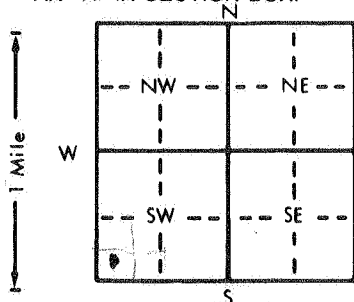

Depth(s) Groundwater Encountered 1. 98 ft. ft. 2. ft. 3. ft.
 WELL'S STATIC WATER LEVEL 98 ft. ft. below land surface measured on mo/day/yr July 6, 88
 Pump test data: Well water was ft. after hours pumping gpm
 Est. Yield 1/5 gpm: Well water was ft. after hours pumping gpm
 Bore Hole Diameter 15 in. to 24 in. to 11 in. to 71 in.
 WELL WATER TO BE USED AS: 5 Public water supply 8 Air conditioning 11 Injection well
 1 Domestic 3 Feedlot 6 Oil field water supply 9 Dewatering 12 Other (Specify below)
 2 Irrigation 4 Industrial 7 Lawn and garden only 10 Observation well
 Was a chemical/bacteriological sample submitted to Department? Yes X No X; If yes, mo/day/yr sample was submitted
 Water Well Disinfected? Yes X No

5 TYPE OF BLANK CASING USED: 5 Wrought iron 8 Concrete tile CASING JOINTS: Glued X Clamped
 1 Steel 3 RMP (SR) 6 Asbestos-Cement 9 Other (specify below) Welded
 2 PVC 4 ABS 7 Fiberglass Threaded

Blank casing diameter 12 in. to 24 in. Dia 6 in. to 71 in. Dia in. to ft.
 Casing height above land surface 15 in. weight lbs./ft. Wall thickness or gauge No. .49 / .255

TYPE OF SCREEN OR PERFORATION MATERIAL: 7 PVC 10 Asbestos-cement
 1 Steel 3 Stainless steel 5 Fiberglass 8 RMP (SR) 11 Other (specify)
 2 Brass 4 Galvanized steel 6 Concrete tile 9 ABS 12 None used (open hole)

SCREEN OR PERFORATION OPENINGS ARE: 5 Gauzed wrapped 8 Saw cut 11 None (open hole)
 1 Continuous slot 3 Mill slot 6 Wire wrapped 9 Drilled holes
 2 Louvered shutter 4 Key punched 7 Torch cut 10 Other (specify)

SCREEN-PERFORATED INTERVALS: From 58 ft. to 50 ft. From 19 ft. to 9 ft.
 GRAVEL PACK INTERVALS: From 71 ft. to 9 ft. From ft. to ft.
 OKED/Per Phone Consultation with Don Taylor

6 GROUT MATERIAL: 1 Neat cement 2 Cement grout 3 Bentonite 4 Other
 Grout Intervals: From 98 ft. ft. to Surface ft. From ft. to ft. From ft. to ft.

What is the nearest source of possible contamination:
 1 Septic tank 4 Lateral lines 7 Pit privy 10 Livestock pens 14 Abandoned water well
 2 Sewer lines 5 Cess pool 8 Sewage lagoon 11 Fuel storage 15 Oil well/Gas well
 3 Watertight sewer lines 6 Seepage pit 9 Feedyard 12 Fertilizer storage 16 Other (specify below)
 13 Insecticide storage

Direction from well? SOUTH How many feet? 200 ft.

FROM	TO	LITHOLOGIC LOG	FROM	TO	LITHOLOGIC LOG
0	1	Topsoil			
1	9	Clay			
9	10	SAND ROCK			
10	11	LIME (Broken)			
11	23	SAND & SHALE			
23	25	LIME			
25	28	BROKEN LIME (Fractured)			
28	71	LIME			

7 CONTRACTOR'S OR LANDOWNER'S CERTIFICATION: This water well was X constructed, (2) reconstructed, or (3) plugged under my jurisdiction and was completed on (mo/day/year) 6 July 88 and this record is true to the best of my knowledge and belief. Kansas Water Well Contractor's License No. 491 This Water Well Record was completed on (mo/day/yr) Aug 1 88 under the business name of Gray Jackson Drilling by (signature) Gray Jackson

INSTRUCTIONS: Use typewriter or ball point pen. PLEASE PRESS FIRMLY and PRINT clearly. Please fill in blanks, underline or circle the correct answers. Send top three copies to Kansas Department of Health and Environment, Bureau of Water Protection, Topeka, Kansas 66620-7320, Telephone: 913-862-9360. Send one to WATER WELL OWNER and retain one for your records.