WATER WELL PLUGGING RECORD	Form WWC-5P K	SA 82a-1212	ID NO.	MW1					
1 17	raction	Section Number	1 1	Range Number					
County: Allen Street/Rural Address of Well Location; if unknown	SE 1/4 SE 1/4 NE 1/4 NW !		T 25 S	18 X E W					
direction from nearest town or intersection: If at owner's address,		Global Positioning Systems (GPS) information: Latitude: 37.87493 (in decimal degrees)							
check here		Longitude: 95.38205 (in decimal degrees)							
1505 1/2		Elevation: NA							
1705 Minnesota Rd, Iola, KS		Horizontal Datum X WGS84, NAD83, NAD27 Collection Method:							
2 WATER WELL OWNER: Allen County Public Works RR#, St. Address, Box #: 1 N Washington City, State ZIP Code: Iola, KS 66749									
		GPS unit (Make/model: Digital Map/Photo, Topographic Map Land Survey							
	E	st. Accuracy:	<pre><3 m, 3-5 m,</pre>	5-15 m, >15 m					
3 MARK WELL'S LOCATION	DEPTH OF WELL	11.9	ft.						
WITH AN "X" IN SECTION		:							
BOX:	WELL'S STATIC WATER LEVELft								
WELL WAS USED AS:									
NW X NE									
Domestic Public Water Supply Dewatering Irrigation Oil Field Water Supply X Monitoring Feedlot Domestic (Lawn & Garden) Injetion Well Industrial Air Conditioning Other									
					Was a chemical/bacteriological sample submitted to Department? Yes No X				
5 TYPE OF BLANK CASING USED:									
Steel RMP (SR) Wrought Fiberglass Other (Specific below)									
Steel RMP (SR) Wrought Fiberglass Other (Specific below) X PVC ABS Concrete Tile									
Blank casing diameter 2 in. Was casing pulled? Yes X No If yes, how much 3' Casing heigh above or below land surface NA in.									
6 GROUT PLUG MATERIAL: Neat cement Cement grout X Bentonite X Other Soil: 0-3'									
Grout Plug Intervals: From3 ft to11.9 ft, From ft to ft, From ft to ft,									
What is the nearest source of possible contamination:									
Septic tank Seepage pit Fuel storage Other (specify below) Sewer lines Pit privy Fertilizer storage									
Watertight sewer lines Sewage lagoon Insecticide storage									
Lateral lines Feed yard Abandoned water well Direction from well?									
Cess pool Dil well/Gas well How many feet?									
FROM TO PLUGGING	MATERIALS	FROM TO) PLUGGING	MATERIALS					
0 3 Soil									
3 11.9 Bentonite									
KDHE ID: Allen County Airport; U3-001-15186				-15186					
7 CONTRACTOR'S OR LANDOWNER'S CERTIFICATION: This water well was plugged under my jurisdiction and was									
completed on (mo/day/year) 7/27/2022 and this record is true to the best of my knowledge and belief. Kansas Water Contractor's License No. 757. This Water Well Record was completed on (mo/day/year) 8/9/2022 under the									
business name of Larsen & Associates, Inc. By (signature)									
Send one white copy to Kansas Department of Health & Environment, Geology Section, 1000 States on Street Six 420, Topeka, KS									
66612-1367. Send one copy to WATER WELL OWNER and retain one for your records									
Visit us at http://www.kdheks.gov/waterwell/index.html Telephone 785-296-5524.									
KSA82a-1212 Revised 1/20/2015									

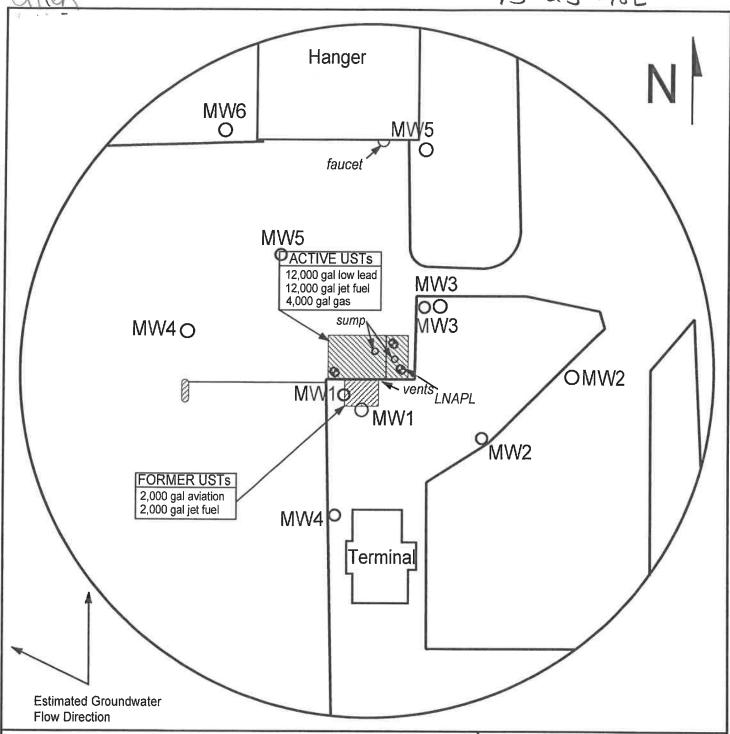


FIGURE 1 - SITE BASE MAP



1311 E 25th St., Suite B (785) 841-8707 office Lawrence, KS 66046 (785) 865-4282 fax

PROJECT:

Allen County Airport 1705 Minnesota Road Iola, KS KDHE ID: U3-001-15186 Date: 7/27/22

50 ft

0. 1121122

LEGEND

Approximate Location of Former UST Basin

Approximate Location of Active UST Basin, Product Line & Pump Island

___ _ Approximate Location of Property Line

O Plugged Well

Observation Well