


2511146 WCC-7

WATER WELL RECORD Form WWC-5 KSA 82a-1212

1 LOCATION OF WATER WELL:	Fraction	Section Number	Township Number	Range Number
County: Sedgwick	NE 1/4 SE 1/4 SW 1/4	26	T 25 S	R 2 EW

Distance and direction from nearest town or city street address of well if located within city?
Approx 10 miles NE of Wichita

2 WATER WELL OWNER: KIES
 RR#, St. Address, Box #: PO Box 745
 City, State, ZIP Code: Wichita KS 67201
 Board of Agriculture, Division of Water Resources
 Application Number:

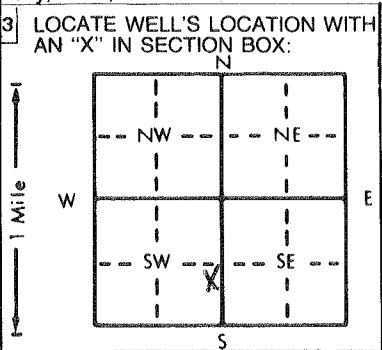

4 DEPTH OF COMPLETED WELL: 39 ft. ELEVATION:

Depth(s) Groundwater Encountered 1. ft. 2. ft. 3. ft.

WELL'S STATIC WATER LEVEL ft. below land surface measured on mo/day/yr

Pump test data: Well water was ft. after hours pumping gpm

Est. Yield gpm Well water was ft. after hours pumping gpm

Bore Hole Diameter in. to ft., and in. to ft.

WELL WATER TO BE USED AS:

5 Public water supply	8 Air conditioning	11 Injection well
1 Domestic <u>was</u>	3 Feedlot	6 Oil field water supply
2 Irrigation	4 Industrial	7 Lawn and garden only
		9 Dewatering
		10 <u>Monitoring well</u>
		12 Other (Specify below)

Was a chemical/bacteriological sample submitted to Department? Yes No X; If yes, mo/day/yr sample was submitted

Water Well Disinfected? Yes No X

5 TYPE OF BLANK CASING USED:

1 Steel	3 RMP (SR)	5 Wrought iron	8 Concrete tile	CASING JOINTS: Glued <u>X</u> Clamped
<u>2 PVC</u>	4 ABS	6 Asbestos-Cement	9 Other (specify below)	Welded
Blank casing diameter in. to ft., Dia in. to ft., Dia in. to ft.		7 Fiberglass		Threaded
Casing height above land surface <u>3 ft below</u> weight lbs./ft. Wall thickness or gauge No. <u>Sch 40</u>				

TYPE OF SCREEN OR PERFORATION MATERIAL:

1 Steel	3 Stainless steel	5 Fiberglass	8 RMP (SR)	10 Asbestos-cement
2 Brass	4 Galvanized steel	6 Concrete tile	9 ABS	11 Other (specify)
SCREEN OR PERFORATION OPENINGS ARE:		5 Gauzed wrapped	8 <u>Saw cut</u>	12 None used (open hole)
1 Continuous slot	3 Mill slot	6 Wire wrapped	9 Drilled holes	
2 Louvered shutter	4 Key punched	7 Torch cut	10 Other (specify)	

SCREEN-PERFORATED INTERVALS: From 29 ft. to 39 ft., From ft. to ft.

GRAVEL PACK INTERVALS: From 29 ft. to 39 ft., From ft. to ft.

6 GROUT MATERIAL: Neat cement 2 Cement grout 3 Bentonite 4 Other

Grout Intervals: From 0 ft. to 26 ft., From 26 ft. to 29 ft., From ft. to ft.

What is the nearest source of possible contamination:

1 Septic tank	4 Lateral lines	7 Pit privy	10 Livestock pens	14 Abandoned water well
2 Sewer lines	5 Cess pool	8 Sewage lagoon	11 Fuel storage	15 Oil well/Gas well
3 Watertight sewer lines	6 Seepage pit	9 Feedyard	12 Fertilizer storage	16 <u>Other (specify below)</u>
			13 Insecticide storage	<u>Solid waste disposal</u>

Direction from well? NW How many feet? 750 Trench

FROM	TO	LITHOLOGIC LOG	FROM	TO	PLUGGING INTERVALS
0	4	Clay topsoil	0	3	fill
4	28	Silty clay	3	39	Bentonite
28	29	Silty clay			
29	35	Silty clay			
35	39	Silty clay			

7 CONTRACTOR'S OR LANDOWNER'S CERTIFICATION: This water well was (1) constructed, (2) reconstructed, or (3) plugged under my jurisdiction and was completed on (mo/day/year) 10-29-97 and this record is true to the best of my knowledge and belief. Kansas Water Well Contractor's License No. 531 This Water Well Record was completed on (mo/day/yr) 11-13-97 under the business name of GST by (signature) Alison M. Jones

INSTRUCTIONS: Use typewriter or ball point pen. PLEASE PRESS FIRMLY and PRINT clearly. Please fill in blanks, underline or circle the correct answers. Send top three copies to Kansas Department of Health and Environment, Bureau of Water, Topeka, Kansas 66620-0001. Telephone: 913-296-5545. Send one to WATER WELL OWNER and retain one for your records.