

251146


WCC-3

WATER WELL RECORD Form WWC-5 KSA 82a-1212

1 LOCATION OF WATER WELL:	Fraction	Section Number	Township Number	Range Number
County: Sedgewick	SW 1/4 SW 1/4 SW 1/4	26	T 25 S	R 2 EW

Distance and direction from nearest town or city street address of well if located within city?  
 Approx. 10 miles NE of Wichita

2 WATER WELL OWNER: KIES  
 RR#, St. Address, Box #: PO Box 745  
 City, State, ZIP Code: Wichita KS 67201  
 Board of Agriculture, Division of Water Resources  
 Application Number:

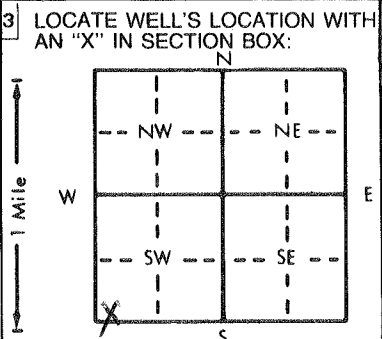

4 DEPTH OF COMPLETED WELL: 48.6 ft. ELEVATION:

Depth(s) Groundwater Encountered 1. . . . . ft. 2. . . . . ft. 3. . . . . ft.

WELL'S STATIC WATER LEVEL . . . . . ft. below land surface measured on mo/day/yr . . . . .

Pump test data: Well water was . . . . . ft. after . . . . . hours pumping . . . . . gpm

Est. Yield . . . . . gpm: Well water was . . . . . ft. after . . . . . hours pumping . . . . . gpm

Bore Hole Diameter . . . . . in. to . . . . . ft., and . . . . . in. to . . . . . ft.

WELL WATER TO BE USED AS:

5 Public water supply	8 Air conditioning	11 Injection well
1 Domestic	3 Feedlot	6 Oil field water supply
2 Irrigation	4 Industrial	7 Lawn and garden only
		9 Dewatering
		12 Other (Specify below)

10 Monitoring well

Was a chemical/bacteriological sample submitted to Department? Yes . . . . . No  . . . . .; If yes, mo/day/yr sample was sub-  
 mitted Water Well Disinfected? Yes . . . . . No

5 TYPE OF BLANK CASING USED:

1 Steel	3 RMP (SR)	5 Wrought iron	8 Concrete tile	CASING JOINTS: Glued <input checked="" type="checkbox"/> . . . . . Clamped . . . . .
2 PVC	4 ABS	6 Asbestos-Cement	9 Other (specify below)	Welded . . . . .
		7 Fiberglass		Threaded . . . . .

Blank casing diameter . . . . . in. to 38.5 . . . . . ft., Dia . . . . . in. to . . . . . ft., Dia . . . . . in. to . . . . . ft.

Casing height above land surface . . . . . 3 ft. below . . . . . in., weight . . . . . lbs./ft. Wall thickness or gauge No. Sch 40

TYPE OF SCREEN OR PERFORATION MATERIAL:

1 Steel	3 Stainless steel	5 Fiberglass	8 RMP (SR)	11 Other (specify) . . . . .
2 Brass	4 Galvanized steel	6 Concrete tile	9 ABS	12 None used (open hole)

SCREEN OR PERFORATION OPENINGS ARE:

1 Continuous slot	3 Mill slot	5 Gauzed wrapped	8 Saw cut	11 None (open hole)
2 Louvered shutter	4 Key punched	6 Wire wrapped	9 Drilled holes	
		7 Torch cut	10 Other (specify) . . . . .	

SCREEN-PERFORATED INTERVALS: From . . . . . 38.5 . . . . . ft. to . . . . . 48.5 . . . . . ft., From . . . . . ft. to . . . . . ft.

GRAVEL PACK INTERVALS: From . . . . . 38.5 . . . . . ft. to . . . . . 48.5 . . . . . ft., From . . . . . ft. to . . . . . ft.

6 GROUT MATERIAL: Neat cement 2 Cement grout 3 Bentonite 4 Other

Grout Intervals: From . . . . . 0 . . . . . ft. to . . . . . 35.5 . . . . . ft., From . . . . . 35.5 . . . . . ft. to . . . . . 38.5 . . . . . ft., From . . . . . ft. to . . . . . ft.

What is the nearest source of possible contamination:

1 Septic tank	4 Lateral lines	7 Pit privy	10 Livestock pens	14 Abandoned water well
2 Sewer lines	5 Cess pool	8 Sewage lagoon	11 Fuel storage	15 Oil well/Gas well
3 Watertight sewer lines	6 Seepage pit	9 Feedyard	12 Fertilizer storage	16 Other (specify below)
			13 Insecticide storage	

Direction from well? N How many feet? 1600

FROM	TO	LITHOLOGIC LOG	FROM	TO	PLUGGING INTERVALS
0	8	Clay Topsoil	0	3	fill
8	19	silty Clay	3	32	Bentonite
19	23	silty Clay			
23	49	silty Clay			

Note well blocked at 32 feet. Could not get unblocked.

7 CONTRACTOR'S OR LANDOWNER'S CERTIFICATION: This water well was (1) constructed, (2) reconstructed, or (3) plugged under my jurisdiction and was completed on (mo/day/year) 10-24-97 and this record is true to the best of my knowledge and belief. Kansas Water Well Contractor's License No. 531 This Water Well Record was completed on (mo/day/yr) 11-13-97 under the business name of GSI by (signature) Alison M. Swin