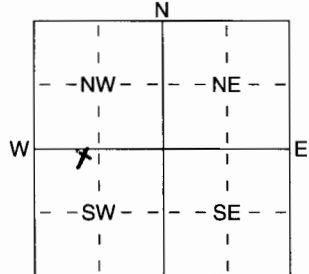


1 LOCATION OF WATER WELL: Fraction **NE 1/4 NW 1/4 SW 1/4** Section Number **26** Township Number **T 25 S** Range Number **R 2 E/W**
 County: **SEDGWICK**

Distance and direction from nearest town or city street address of well if located within city?
3 miles SE of FURLEY, KS

2 WATER WELL OWNER: **NIES**
 RR#, St. Address, Box # : **8808 N. 127th East** Board of Agriculture, Division of Water Resources
 City, State, ZIP Code : **Valley Center, KS 67147** Application Number:

3 LOCATE WELL'S LOCATION WITH AN "X" IN SECTION BOX:

 4 DEPTH OF COMPLETED WELL **60.5** ft. ELEVATION: **1388.04**
 Depth(s) Groundwater Encountered 1 ft. 2 ft. 3 ft.
 WELL'S STATIC WATER LEVEL **55.3** ft. below land surface measured on mo/day/yr **3/24/06**
 Pump test data: Well water was ft. after hours pumping gpm
 Est. Yield gpm: Well water was ft. after hours pumping gpm
 WELL WATER TO BE USED AS: 5 Public water supply 8 Air conditioning 11 Injection well
 1 Domestic 3 Feedlot 6 Oil field water supply 9 Dewatering 12 Other (Specify below)
 2 Irrigation 4 Industrial 7 Domestic (lawn & garden) **10 Monitoring well**

5 TYPE OF BLANK CASING USED: 5 Wrought iron 8 Concrete tile CASING JOINTS: Glued Clamped
 1 Steel 3 RMP (SR) 6 Asbestos-Cement 9 Other (specify below) Welded
2 PVC 4 ABS 7 Fiberglass **Threaded**
 Blank casing diameter **2** in. to **55.5** ft., Dia in. to ft., Dia in. to ft.
 Casing height above land surface **2.53** in., weight lbs./ft. Wall thickness or gauge No. **Sch 40**
 TYPE OF SCREEN OR PERFORATION MATERIAL: **7 PVC** 10 Asbestos-Cement
 1 Steel 3 Stainless Steel 5 Fiberglass 8 RMP (SR) 11 Other (Specify)
 2 Brass 4 Galvanized Steel 6 Concrete tile 9 ABS 12 None used (open hole)
 SCREEN OR PERFORATION OPENINGS ARE: 5 Gauzed wrapped 8 Saw cut 11 None (open hole)
 1 Continuous slot **3 Mill slot** 6 Wire wrapped 9 Drilled holes
 2 Louvered shutter 4 Key punched 7 Torch cut 10 Other (specify) ft.

6 GROUT MATERIAL: 1 Neat cement 2 Cement grout **3 Bentonite** 4 Other
 Grout Intervals: From **52** ft. to **0** ft., From ft. to ft., From ft. to ft.
 What is the nearest source of possible contamination:
 1 Septic tank 4 Lateral lines 7 Pit privy 10 Livestock pens 14 Abandoned water well
 2 Sewer lines 5 Cess pool 8 Sewage lagoon 11 Fuel storage 15 Oil well/Gas well
 3 Watertight sewer lines 6 Seepage pit 9 Feedyard 12 Fertilizer storage **16 Other (specify below)**
 Direction from well? **South** How many feet? **100** **former disposal cells**

FROM	TO	LITHOLOGIC LOG	FROM	TO	PLUGGING INTERVALS
0	13	SILT, yellowish brown			
13	48	CLAY, yellowish orange, low plasticity			
48	57	SHALE, brown to gray, soft, weak			
57	60	SHALE, olive gray, weak			
60	62	SHALE, gray, Mod. weak			

7 CONTRACTOR'S OR LANDOWNER'S CERTIFICATION: This water well was **(1) constructed**, (2) reconstructed, or (3) plugged under my jurisdiction and was completed on (mo/day/year) **3/8/06** and this record is true to the best of my knowledge and belief. Kansas Water Well Contractor's Licence No **708** This Water Well Record was completed on (mo/day/yr) **4/28/06** under the business name of **Aquaterra Environmental Solutions** by (signature) 