


1 LOCATION OF WATER WELL: Fraction SE 1/4 SW 1/4 NW 1/4 Section Number 26 Township Number T 25 S Range Number R 2 E
 County: SEDGWICK

Distance and direction from nearest town or city street address of well if located within city?
3 miles SE of FURLEY, KS

2 WATER WELL OWNER: NIES
 RR#, St. Address, Box # : 8808 N. 127th East
 City, State, ZIP Code : Valley Center, KS 67147
 Board of Agriculture, Division of Water Resources
 Application Number:

3 LOCATE WELL'S LOCATION WITH 4 DEPTH OF COMPLETED WELL 55.56 ft. ELEVATION: 1383.80

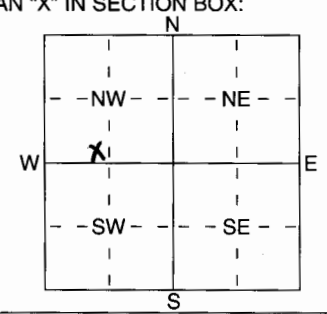

Depth(s) Groundwater Encountered 1 50.4 ft. 2 ft. 3 ft.
 WELL'S STATIC WATER LEVEL 50.4 ft. below land surface measured on mo/day/yr
 Pump test data: Well water was ft. after hours pumping gpm
 Est. Yield gpm: Well water was ft. after hours pumping gpm
 WELL WATER TO BE USED AS: 5 Public water supply 8 Air conditioning 11 Injection well
 1 Domestic 3 Feedlot 6 Oil field water supply 9 Dewatering 12 Other (Specify below)
 2 Irrigation 4 Industrial 7 Domestic (lawn & garden) 10 Monitoring well

Was a chemical/bacteriological sample submitted to Department? Yes No X; If yes, mo/day/yr sample was submitted
 Water Well Disinfected? Yes No

5 TYPE OF BLANK CASING USED: 1 Steel 3 RMP (SR) 5 Wrought iron 8 Concrete tile CASING JOINTS: Glued Clamped
2 PVC 4 ABS 7 Fiberglass 9 Other (specify below) Welded
 Blank casing diameter 2 in. to 50.5 ft., Dia in. to ft., Dia in. to ft.
 Casing height above land surface 2.67 in., weight lbs./ft. Wall thickness or gauge No. Sch 40

TYPE OF SCREEN OR PERFORATION MATERIAL: 1 Steel 3 Stainless Steel 5 Fiberglass 7 PVC 10 Asbestos-Cement
 2 Brass 4 Galvanized Steel 6 Concrete tile 8 RMP (SR) 11 Other (Specify)
 9 ABS 12 None used (open hole)

SCREEN OR PERFORATION OPENINGS ARE: 1 Continuous slot 3 Mill slot 5 Gauzed wrapped 8 Saw cut 11 None (open hole)
 2 Louvered shutter 4 Key punched 6 Wire wrapped 9 Drilled holes
 7 Torch cut 10 Other (specify) ft.

SCREEN-PERFORATED INTERVALS: From 50.5 ft. to 55.5 ft., From ft. to ft.
 GRAVEL PACK INTERVALS: From 48 ft. to 55.56 ft., From ft. to ft.

6 GROUT MATERIAL: 1 Neat cement 2 Cement grout 3 Bentonite 4 Other
 Grout Intervals: From 0 ft. to 48 ft., From ft. to ft., From ft. to ft.

What is the nearest source of possible contamination:
 1 Septic tank 4 Lateral lines 7 Pit privy 10 Livestock pens 14 Abandoned water well
 2 Sewer lines 5 Cess pool 8 Sewage lagoon 11 Fuel storage 15 Oil well/Gas well
 3 Watertight sewer lines 6 Seepage pit 9 Feedyard 12 Fertilizer storage 16 Other (specify below)
former disposal cells
 Direction from well? 250 How many feet? South

FROM	TO	LITHOLOGIC LOG	FROM	TO	PLUGGING INTERVALS
0	8	CLAY, silty, rusty			
8	48	CLAY, olive, high plasticity			
48	54	CLAY SHALE, olive gray w/nodules			
54	56	SHALE, bluish gray, vuggy			
56	57	SHALE, olive gray			

7 CONTRACTOR'S OR LANDOWNER'S CERTIFICATION: This water well was (1) constructed, (2) reconstructed, or (3) plugged under my jurisdiction and was completed on (mo/day/year) 3/14/06 and this record is true to the best of my knowledge and belief. Kansas Water Well Contractor's Licence No 708 This Water Well Record was completed on (mo/day/yr) 4/24/06 under the business name of Aquaterra Environmental Solutions by (signature) [Signature]