


1 LOCATION OF WATER WELL: Fraction SW 1/4 SW 1/4 SW 1/4 Section Number 23 Township Number T 25 S Range Number R 2 EW  
 County: Sedgwick

Distance and direction from nearest town or city street address of well if located within city?  
Approx. 3 miles SE of Furdy, KS

2 WATER WELL OWNER: Chemical Waste Management  
 RR#, St. Address, Box # : 8808 N 127th St. East Board of Agriculture, Division of Water Resources  
 City, State, ZIP Code : Valley Center, KS 67147 Application Number:

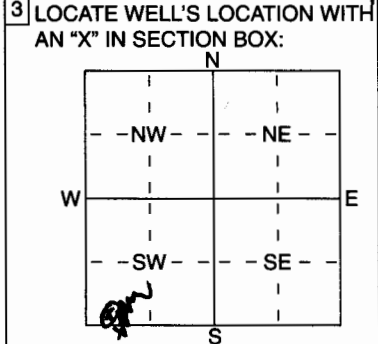

4 DEPTH OF COMPLETED WELL ..... 11.5 has ft. ELEVATION: 1336.8 gs  
 Depth(s) Groundwater Encountered ..... ft. 2 ..... ft. 3 ..... ft.  
 WELL'S STATIC WATER LEVEL 4.57 ft. below land surface measured on mo/day/yr 7-18-07  
 Pump test data: Well water was ..... ft. after ..... hours pumping ..... gpm  
 Est. Yield ..... gpm: Well water was ..... ft. after ..... hours pumping ..... gpm  
 WELL WATER TO BE USED AS: 5 Public water supply 8 Air conditioning 11 Injection well  
 1 Domestic 3 Feedlot 6 Oil field water supply 9 Dewatering 12 Other (Specify below)  
 2 Irrigation 4 Industrial 7 Domestic (lawn & garden) 10 Monitoring well  
 Was a chemical/bacteriological sample submitted to Department? Yes ..... No X; If yes, mo/day/yr sample was submitted  
 Water Well Disinfected? Yes ..... No (No)

5 TYPE OF BLANK CASING USED: 1 Steel 3 RMP (SR) 5 Wrought iron 8 Concrete tile CASING JOINTS: Glued ..... Clamped .....  
2 PVC 4 ABS 7 Fiberglass 9 Other (specify below) Welded  
 Blank casing diameter ..... 2 in. to 8.5 ft., Dia ..... in. to ..... ft., Dia ..... in. to ..... ft.  
 Casing height above land surface 22 in., weight Schd 40 lbs./ft. Wall thickness or gauge No. ....  
 TYPE OF SCREEN OR PERFORATION MATERIAL: 7 PVC 10 Asbestos-Cement  
 1 Steel 3 Stainless Steel 5 Fiberglass 8 RMP (SR) 11 Other (Specify) .....  
 2 Brass 4 Galvanized Steel 6 Concrete tile 9 ABS 12 None used (open hole)  
 SCREEN OR PERFORATION OPENINGS ARE: 5 Gauzed wrapped 8 Saw cut 11 None (open hole)  
 1 Continuous slot 3 Mill slot 6 Wire wrapped 9 Drilled holes  
 2 Louvered shutter 4 Key punched 7 Torch cut 10 Other (specify) ..... ft.  
 SCREEN-PERFORATED INTERVALS: From 8.5 ft. to 11.0 ft., From ..... ft. to ..... ft.  
 GRAVEL PACK INTERVALS: From 6.0 ft. to 11.5 ft., From ..... ft. to ..... ft.

6 GROUT MATERIAL: 1 Neat cement 2 Cement grout 3 Bentonite 4 Other .....  
 Grout Intervals: From 0 ft. to 6 ft., From ..... ft. to ..... ft., From ..... ft. to ..... ft.  
 What is the nearest source of possible contamination: 10 Livestock pens 14 Abandoned water well  
 1 Septic tank 4 Lateral lines 7 Pit privy 11 Fuel storage 15 Oil well/Gas well  
 2 Sewer lines 5 Cess pool 8 Sewage lagoon 12 Fertilizer storage 16 Other (specify below)  
 3 Watertight sewer lines 6 Seepage pit 9 Feedyard 13 Insecticide storage Closed Haz. Waste facility ~ 2000 ft  
 Direction from well? How many feet?

FROM	TO	LITHOLOGIC LOG	FROM	TO	PLUGGING INTERVALS
<u>0</u>	<u>1</u>	<u>Topsoil</u>			
<u>1</u>	<u>10</u>	<u>Brown clay</u>			
<u>10</u>	<u>14</u>	<u>Brown clay/clay</u>			
<u>14</u>	<u>16.5</u>	<u>Gray clay/shale</u>			
	<u>TD</u>				

7 CONTRACTOR'S OR LANDOWNER'S CERTIFICATION: This water well was (1) constructed, (2) reconstructed, or (3) plugged under my jurisdiction and was completed on (mo/day/year) 6-5-07 and this record is true to the best of my knowledge and belief. Kansas Water Well Contractor's Licence No 709 This Water Well Record was completed on (mo/day/yr) 8/9/07 under the business name of Aquiterria by (signature) [Signature]