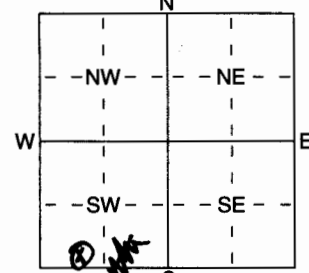


1 LOCATION OF WATER WELL: County: <u>Seelye</u>	Fraction <u>SW 1/4 SW 1/4 SW 1/4</u>	Section Number <u>23</u>	Township Number T <u>25</u> S	Range Number R <u>2</u> EW
--	---	-----------------------------	----------------------------------	-------------------------------

Distance and direction from nearest town or city street address of well if located within city?  
Approx 3 miles SE of Furdy, KS

2 WATER WELL OWNER: Chemical Waste Management  
 RR#, St. Address, Box # : 8808 N 127th St. East  
 City, State, ZIP Code : Valley Center, KS 67147  
 Board of Agriculture, Division of Water Resources  
 Application Number:

3 LOCATE WELL'S LOCATION WITH AN "X" IN SECTION BOX: 	4 DEPTH OF COMPLETED WELL ..... <u>18.5</u> ft. ELEVATION: ..... <u>1338.1</u> ft. Depth(s) Groundwater Encountered 1 ..... <u>8</u> ft. 2 ..... ft. 3 ..... ft. WELL'S STATIC WATER LEVEL ..... <u>7.82</u> ft. below land surface measured on mo/day/yr ..... <u>7-19-07</u> Pump test data: Well water was ..... ft. after ..... hours pumping ..... gpm Est. Yield ..... gpm: Well water was ..... ft. after ..... hours pumping ..... gpm WELL WATER TO BE USED AS: 5 Public water supply 8 Air conditioning <u>11 Injection well</u> 1 Domestic 3 Feedlot 6 Oil field water supply 9 Dewatering 12 Other (Specify below) 2 Irrigation 4 Industrial 7 Domestic (lawn & garden) 10 Monitoring well ..... Was a chemical/bacteriological sample submitted to Department? Yes ..... No ..... <u>X</u> ; If yes, mo/day/yr sample was submitted Water Well Disinfected? Yes ..... No ..... <u>(No)</u>
--	---

5 TYPE OF BLANK CASING USED:  
 1 Steel 2 PVC 3 RMP (SR) 4 ABS  
 5 Wrought iron 6 Asbestos-Cement 7 Fiberglass  
 8 Concrete tile 9 Other (specify below)  
 CASING JOINTS: Glued ..... Clamped .....  
 Welded ..... Threaded .....

Blank casing diameter ..... 2 in. to ..... 10.5 ft., Dia ..... in. to ..... ft., Dia ..... in. to ..... ft.  
 Casing height above land surface ..... 23 in., weight ..... Schd 40 lbs./ft. Wall thickness or gauge No. ....

TYPE OF SCREEN OR PERFORATION MATERIAL:  
 1 Steel 3 Stainless Steel 5 Fiberglass 8 RMP (SR) 10 Asbestos-Cement  
 2 Brass 4 Galvanized Steel 6 Concrete tile 9 ABS 11 Other (Specify) .....  
 12 None used (open hole)

SCREEN OR PERFORATION OPENINGS ARE:  
 1 Continuous slot 3 Mill slot 5 Gauzed wrapped 8 Saw cut 11 None (open hole)  
 2 Louvered shutter 4 Key punched 6 Wire wrapped 9 Drilled holes  
 7 Torch cut 10 Other (specify) .....

SCREEN-PERFORATED INTERVALS: From ..... 10.5 ft. to ..... 18.0 ft., From ..... ft. to ..... ft.  
 From ..... ft. to ..... ft., From ..... ft. to ..... ft.  
 GRAVEL PACK INTERVALS: From ..... 8.0 ft. to ..... 18.5 ft., From ..... ft. to ..... ft.  
 From ..... ft. to ..... ft., From ..... ft. to ..... ft.

6 GROUT MATERIAL: 1 Neat cement 2 Cement grout 3 Bentonite 4 Other .....

Grout Intervals: From ..... 0 ft. to ..... 8 ft., From ..... ft. to ..... ft., From ..... ft. to ..... ft.

What is the nearest source of possible contamination:  
 1 Septic tank 4 Lateral lines 7 Pit privy 10 Livestock pens 14 Abandoned water well  
 2 Sewer lines 5 Cess pool 8 Sewage lagoon 11 Fuel storage 15 Oil well/Gas well  
 3 Watertight sewer lines 6 Seepage pit 9 Feedyard 12 Fertilizer storage 16 Other (specify below)  
Closed Haz Waste Facility ~ 2000 ft  
 Direction from well? How many feet?

FROM	TO	LITHOLOGIC LOG	FROM	TO	PLUGGING INTERVALS
<u>0</u>	<u>1</u>	<u>Topsoil</u>			
<u>1</u>	<u>10</u>	<u>Brown Clay</u>			
<u>10</u>	<u>17</u>	<u>Brown-Gray Clay</u>			
<u>17</u>	<u>18.5</u>	<u>Gray Clay / Shale</u>			

7 CONTRACTOR'S OR LANDOWNER'S CERTIFICATION: This water well was (1) constructed, (2) reconstructed, or (3) plugged under my jurisdiction and was completed on (mo/day/year) ..... 6-7-07 ..... and this record is true to the best of my knowledge and belief. Kansas Water Well Contractor's Licence No ..... 708 ..... This Water Well Record was completed on (mo/day/yr) ..... 8-9-07 ..... under the business name of Aquaterra by (signature) [Signature]